


REVISION	DESCRIPTION	REVISED BY	DATE
1	LEASING		

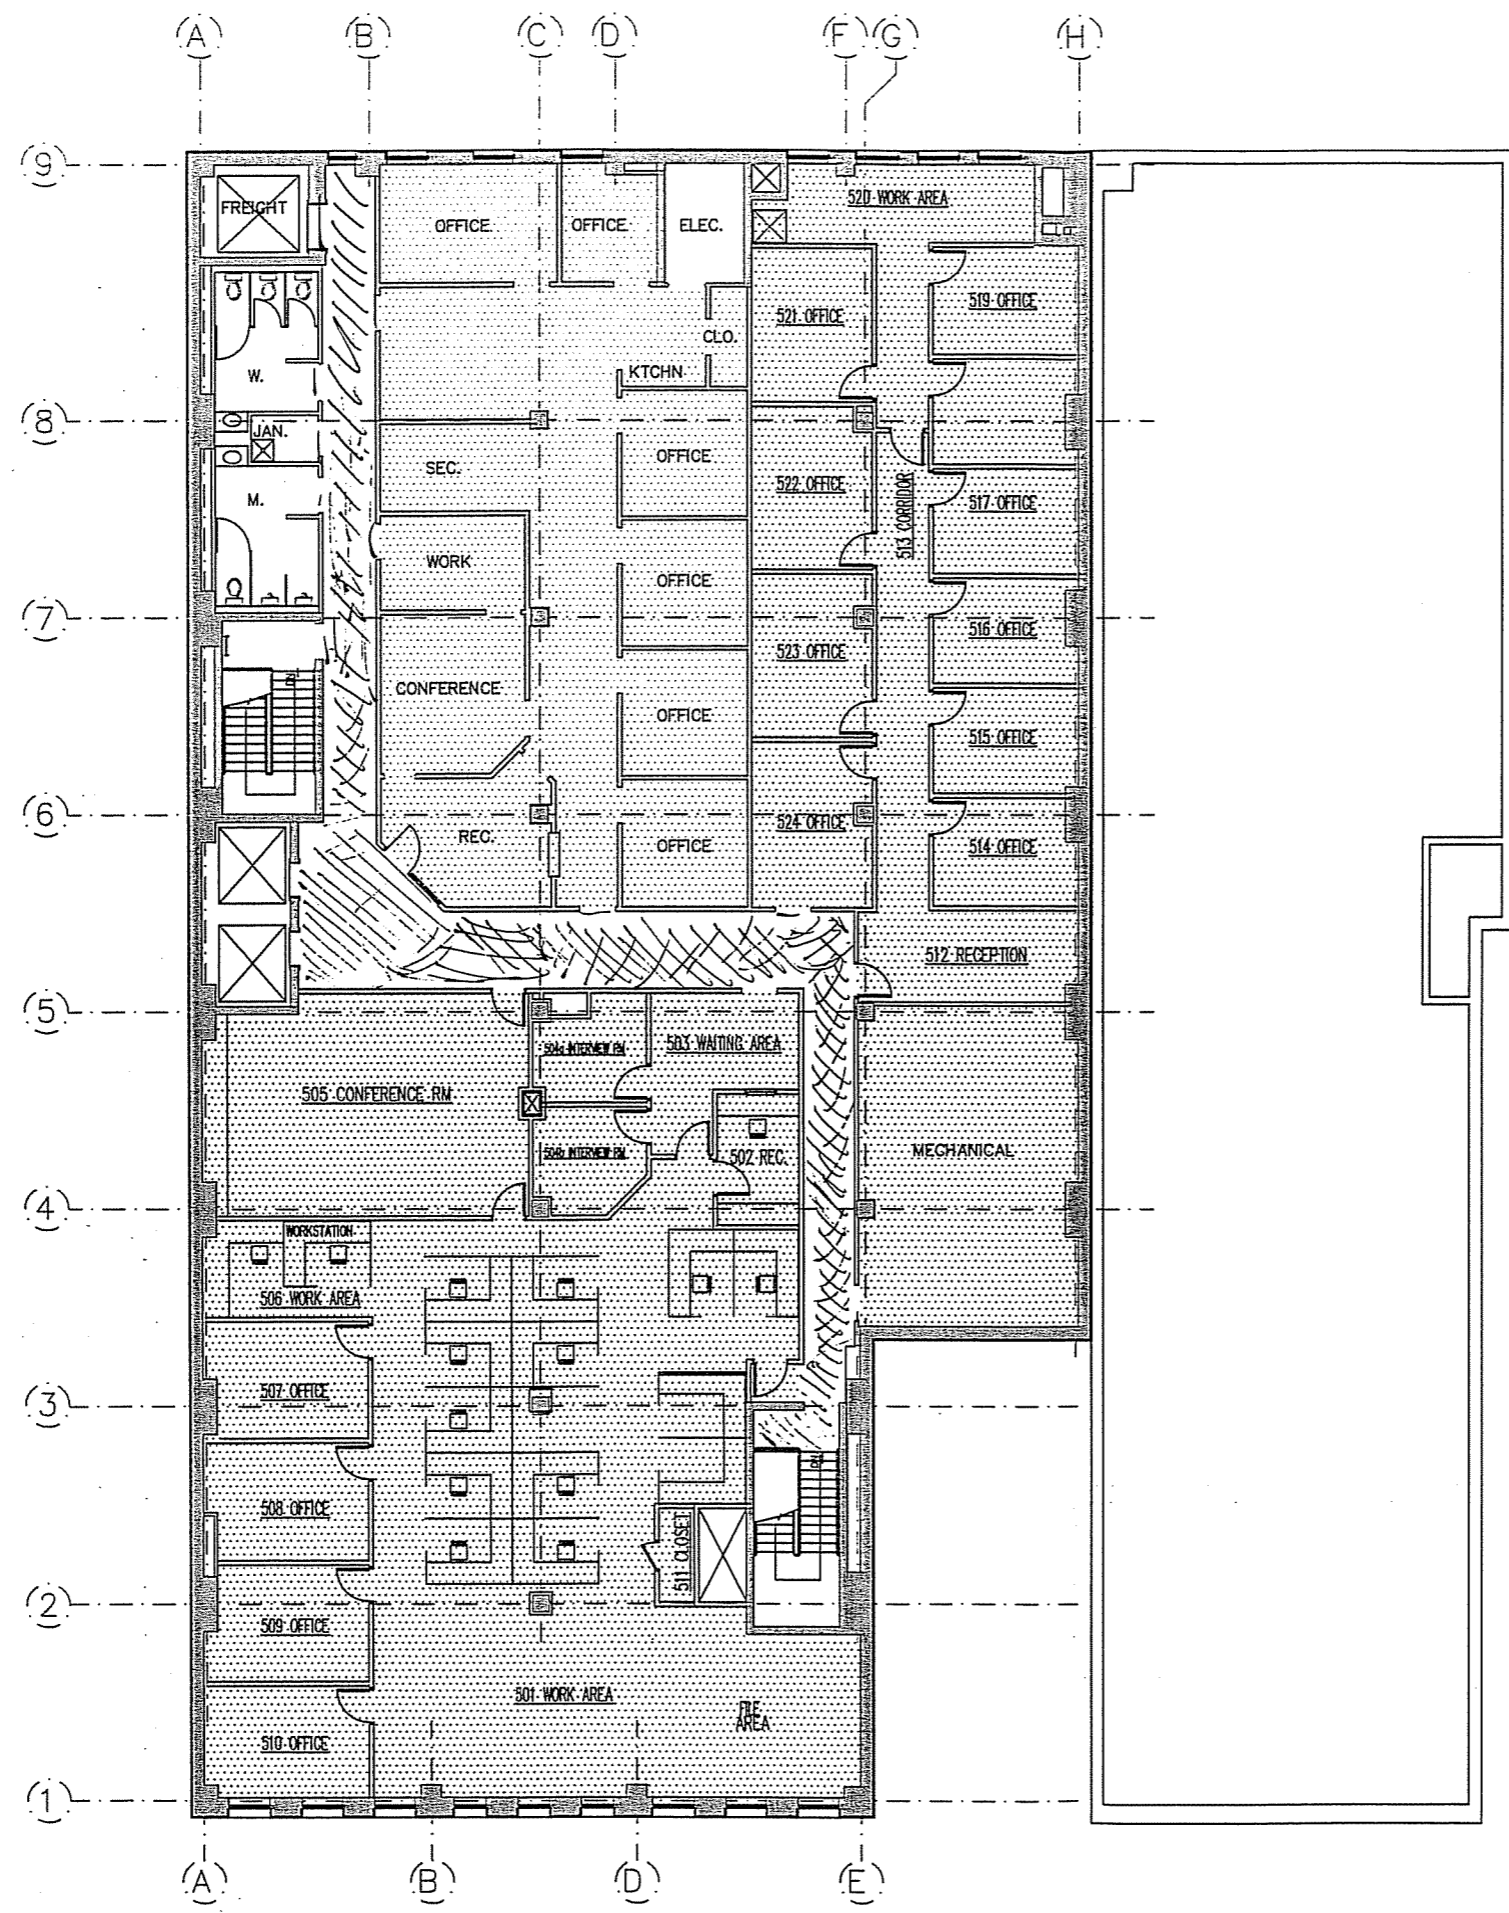

LEASING SPACE ALLOCATION

2200 S.F.	WORKERS COMP
3990 S.F.	DHHR
2125 S.F.	DHHR
580 S.F.	BELL ATLANTIC
GROSS AREA	11855 SQ. FT.
RENTABLE AREA	5665 SQ. FT.
USABLE AREA	3315 SQ. FT.
RENTABLE / USABLE RATIO	1.16

THE ABOVE WERE QUANTIFIED USING BUILDING OWNERS AND MANAGERS ASSOCIATION'S STANDARD FOR MEASURING FLOOR AREA IN OFFICE BUILDINGS(1993), AMERICAN NATIONAL STANDARD(ANSI Z65.1-1989).

NOTE

THIS PLAN SCALED FROM EXISTING FLOOR PLANS. VERIFY ALL DIMENSIONS SCALED FROM PLAN.

STATE OF WEST VIRGINIA
 DEPARTMENT OF ADMINISTRATION DIVISION OF GENERAL SERVICES
 CHARLESTON, WEST VIRGINIA

LOCATION: FAIRMONT, WEST VIRGINIA
 BUILDING: BUILDING 21
 PROJECT: AS-BUILT

DRAWING TITLE: FIFTH FLOOR PLAN
 DRAWN BY: FDU DATE: [REDACTED]

DRAWING NO: A7