




REVISIONS

RECORD DRAWING 9-5-95

**MOUNT OLIVE
 CORRECTIONAL COMPLEX**
 WEST VIRGINIA REGIONAL JAIL & CORRECTIONAL FACILITY AUTHORITY

KEY PLAN

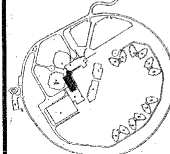


DRAWING TITLE
ROOF PLAN, MENTAL HEALTH

AREA A & E

DATE
 12/9/91

DRAWING NO.
A3.24

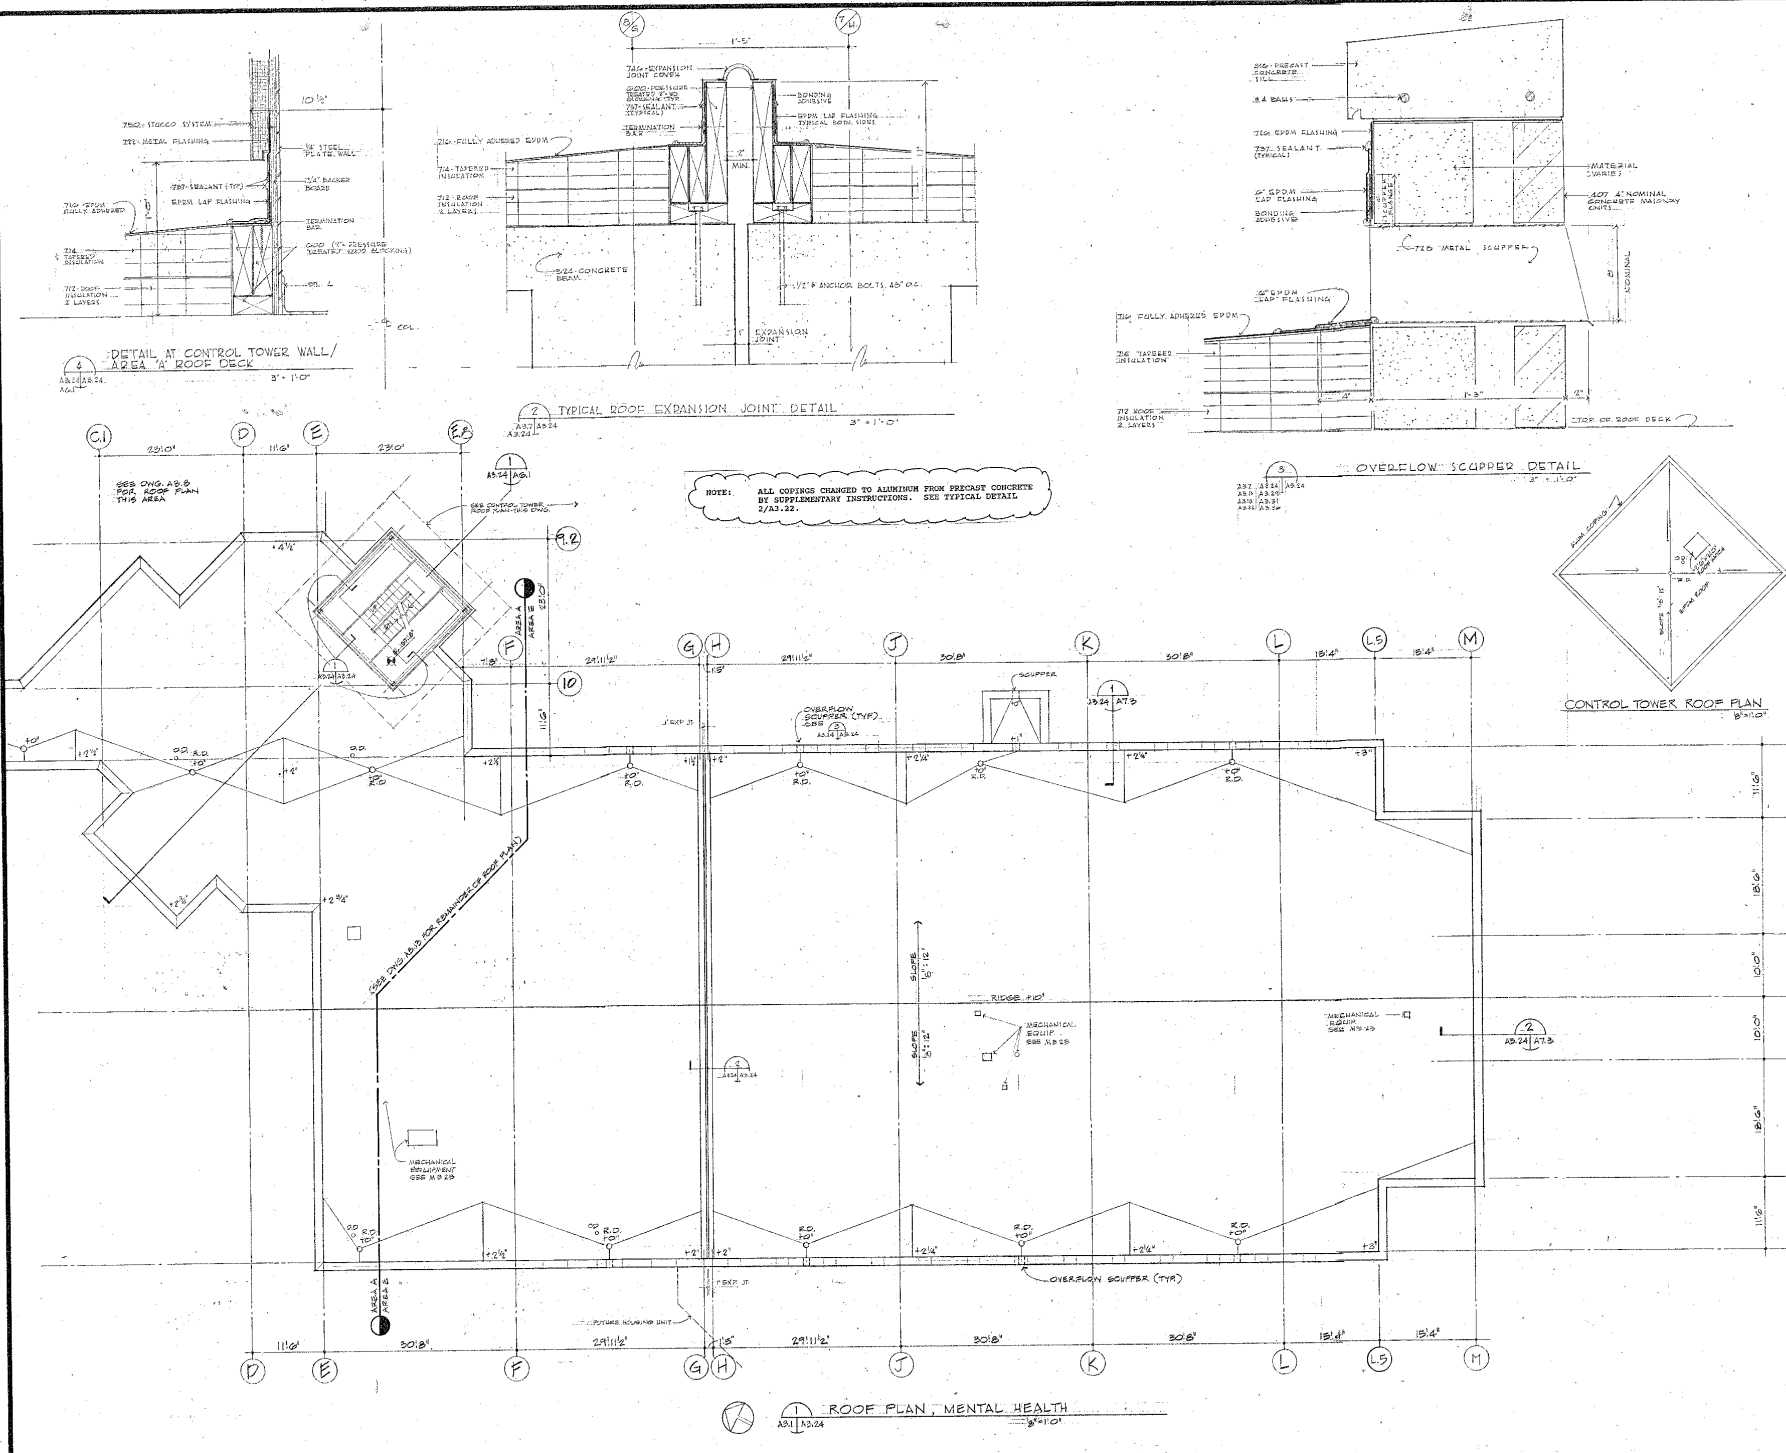

3/5/92