


NOTE: ALL COPINGS CHANGED TO ALUMINUM FROM PRECAST CONCRETE BY SUPPLEMENTARY INSTRUCTIONS. SEE TYPICAL DETAIL 5/A3-22.

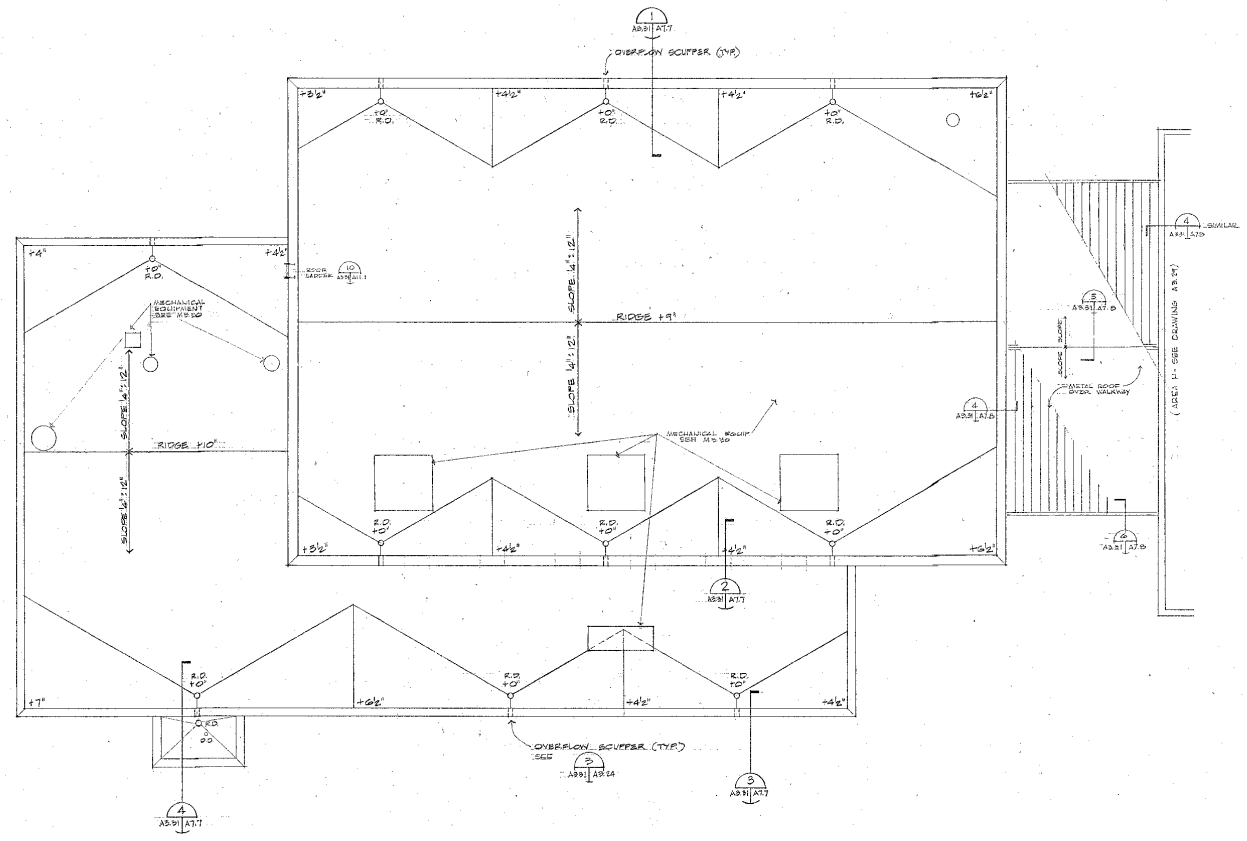

ROOF PLAN - RECREATION CHAPEL
 A3.31

SAI SILLING ASSOCIATES, INC.
 ARCHITECTS - PLANNERS
 400 CHARLOT STREET - SUITE 200 - BOX 607
 CHARLESTON, W. V. 25303 • (204) 348-0808

This drawing and all copies of it are the property of SILLING ASSOCIATES, INC. (SAI). Plans and details are loaned to the contractor for the purpose of construction only. No reproduction or other use is permitted without the written consent of SAI to be permitted.

ROSSER FABRAP


Rosser Fabrap International
 Architects, engineers, and planners
 Atlanta, Savannah, Tampa, San Bernardino County
 124 West Peachtree Street, N.W.
 Atlanta, Georgia 30308-0001
 (404) 525-3828



REVISIONS

RECORD DRAWING 9-5-95

MOUNT OLIVE CORRECTIONAL COMPLEX
 WEST VIRGINIA REGIONAL JAIL & CORRECTIONAL FACILITY AUTHORITY

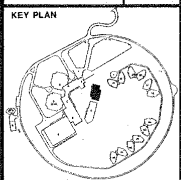

KEY PLAN
 DRAWING TITLE
ROOF PLANS
 RECREATION, CHAPEL

AREA |
 DATE 12/9/91

DRAWING NO. **A3.31**