
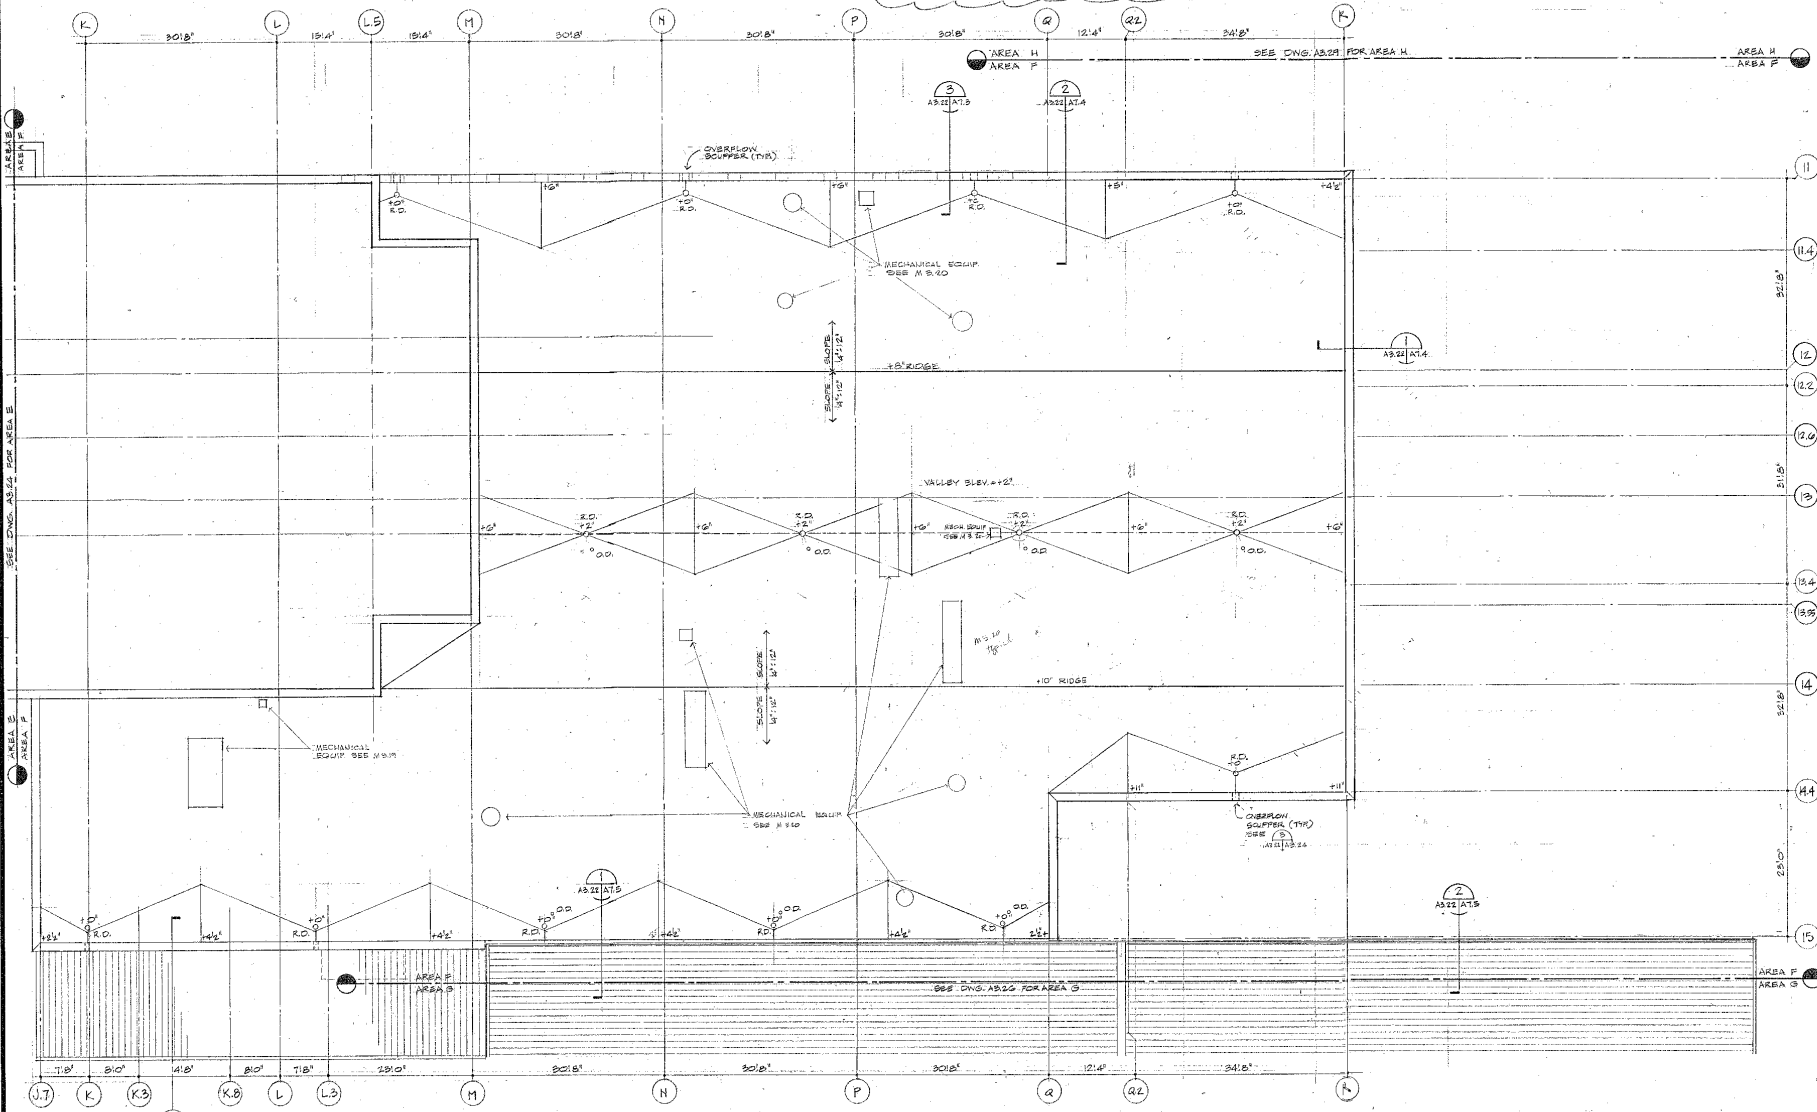


NOTE: ALL COPINGS CHANGED TO ALUMINUM FROM PRECAST CONCRETE BY SUPPLEMENTARY INSTRUCTIONS. SEE TYPICAL DETAIL. 2/83.22.

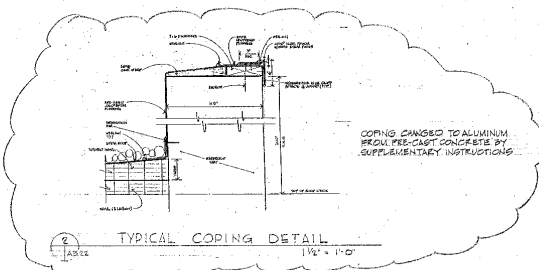

**SAI** SILLING ASSOCIATES, INC.  
ARCHITECTS - PLANNERS  
400 CAPITOL STREET - SUITE 200 - BOX 987  
CHARLESTON, W. V. 25302 - (204) 246-0205

**ROSSER FABRAP**


Rosser Fabrap International  
Architects, engineers, and planners  
Atlanta, Savannah, Tampa, San Bernardino County  
300 West Peachtree Street, 19th  
Atlanta, Georgia 30308 404/525-3800



REVISIONS

RECORD DRAWING 9-5-95

**MOUNT OLIVE CORRECTIONAL COMPLEX**  
WEST VIRGINIA REGIONAL JAIL & CORRECTIONAL FACILITY AUTHORITY

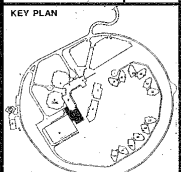

DRAWING TITLE  
**ROOF PLAN, FOOD SERVICES**

AREA F  
DATE 12/9/91

DRAWING NO. **A3.22**

1 ROOF PLAN, FOOD SERVICES  
AS1322 1/4" = 1'-0"