


NOTE: ALL COPINGS CHANGED TO ALUMINUM FROM PRECAST CONCRETE
2/11/95

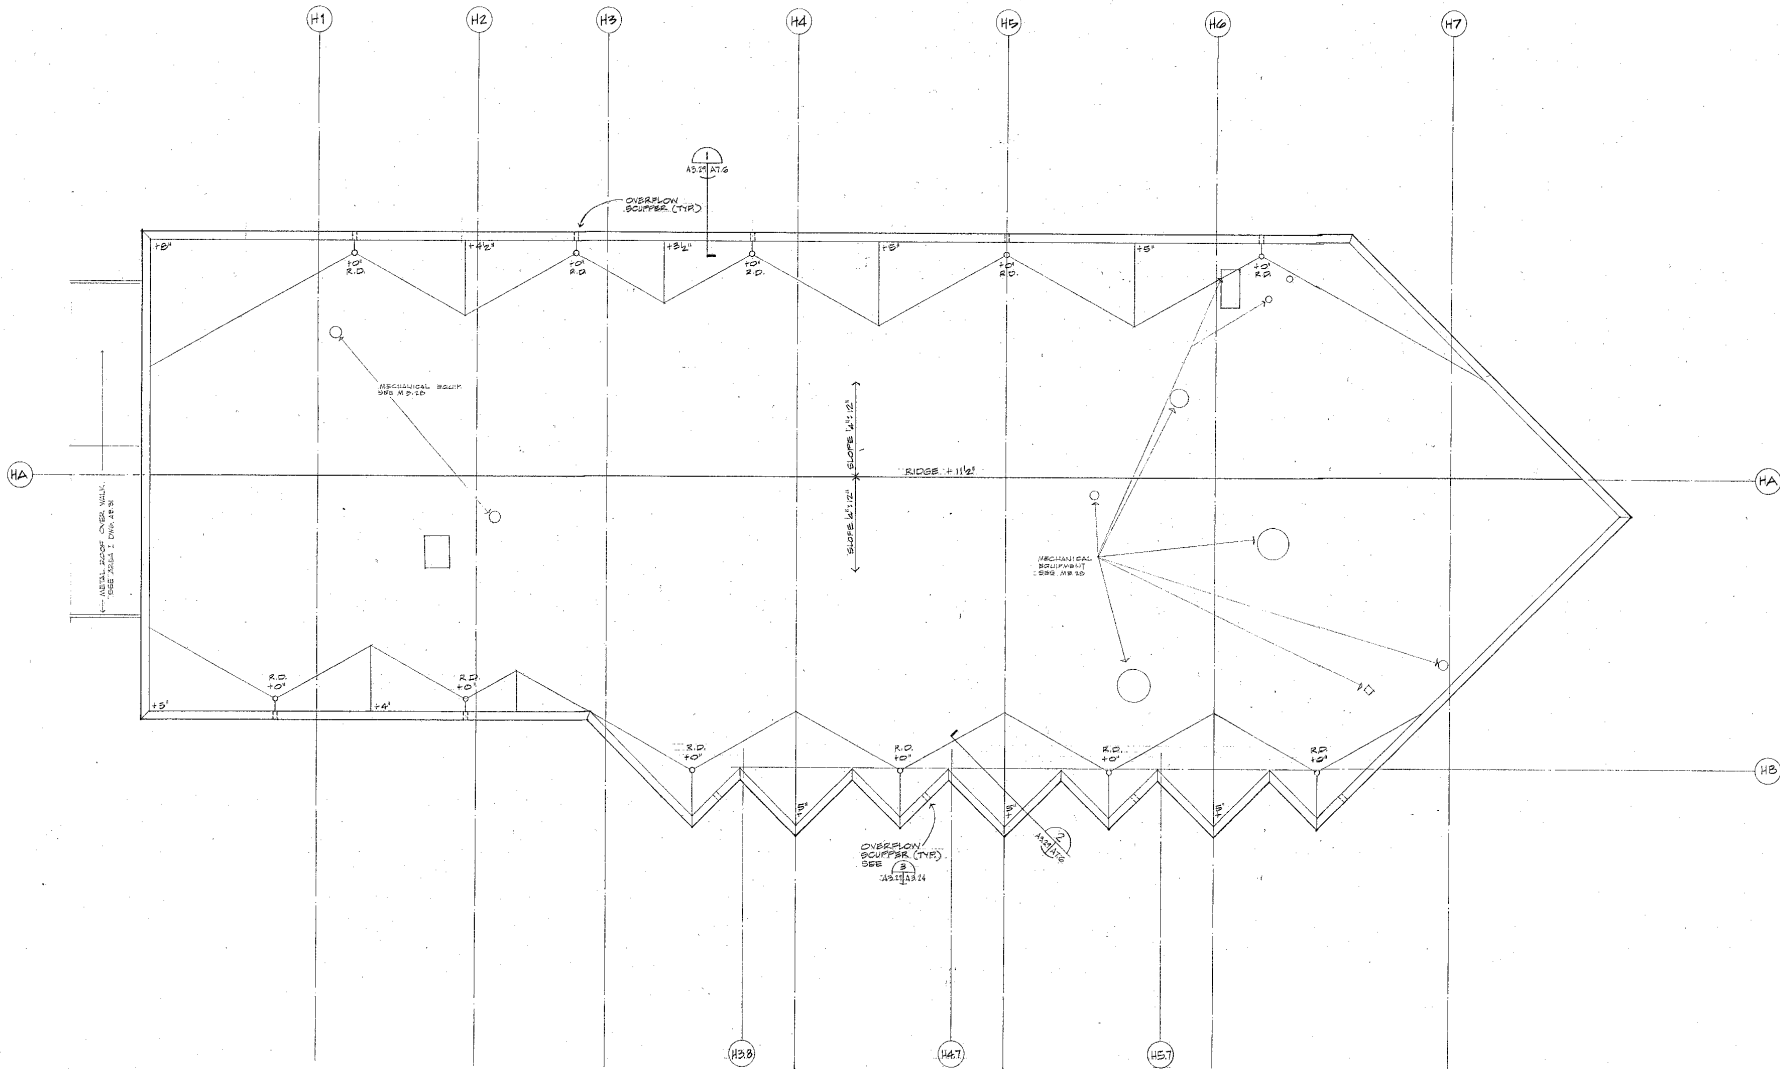

ROOF PLAN - ACADEMIC EDUCATION
AS.1/A3.29

SAI SILLING ASSOCIATES, INC.

ARCHITECTS - PLANNERS
405 CAPITOL STREET - SUITE 500 - BOX 507
CHARLESTON, W. V. 25312 - (606) 525-0000

ROSSER FABRAP


Rosser Fabrap International
Architects, engineers, and planners
Atlanta, Savannah, Tampa, San Bernardino County
574 West Peachtree Street, N.W.
Atlanta, Georgia 30308-5000
(404) 876-3800



REVISIONS

RECORD DRAWING 9-6-95

**MOUNT OLIVE
CORRECTIONAL COMPLEX**
WEST VIRGINIA REGIONAL JAIL & CORRECTIONAL FACILITY AUTHORITY

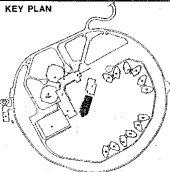

DRAWING TITLE
ROOF PLANS
ACADEMIC EDUCATION

AREA H

DATE 12/9/91

DRAWING NO. **A3.29**