



DETAIL 1
NO SCALE TYPICAL SLAB CONTROL JOINT (S02)


1. PROVIDE TOLDED JOINTS IN FRESH CONCRETE EACH SIDE OF WALLS WHERE SLABS POUR THRU DOORWAYS.
2. PROVIDE A #4 BAR @ 2'-0" AT MID-DEPTH OF THE SLAB PERPENDICULAR TO JOINTS THAT TERMINATE AT A PERPENDICULAR JOINT.
3. THIS DETAIL APPLIES TO ALL SLABS ON GRADE WITH A THICKNESS OF 5" OR LESS.

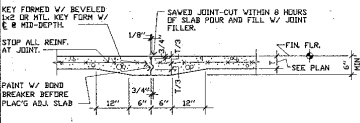


DETAIL 2
NO SCALE TYP. KEYED CONST. JOINT (S02)

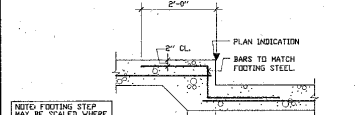


DETAIL 3
NO SCALE TYPICAL FOOTING STEP (S02)

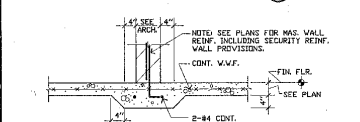


DETAIL 4
NO SCALE TYP. CONSTRUCTION JOINTS IN SLAB ON GRADE AT CONC. COLUMNS (S02)

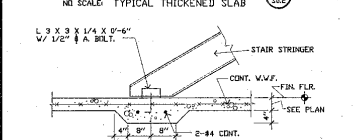


SECTION 4
NO SCALE TYPICAL THICKENED SLAB (S02)

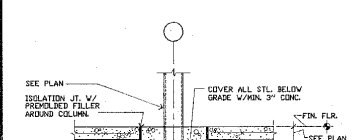

SECTION 5
NO SCALE TYP. CONSTRUCTION JOINTS IN SLAB ON GRADE AT CONC. COLUMNS (S02)

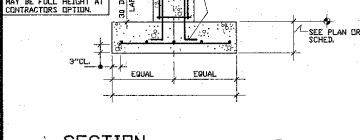


SECTION 6
NO SCALE TYP. SPREAD FTG. W/ PIER (S02)

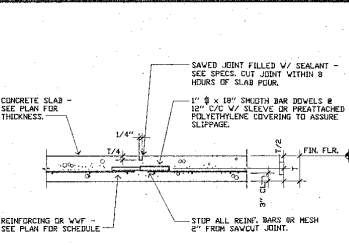


DETAIL 7
NO SCALE TYPICAL DOVELED SLAB CONTROL JOINT (S02)


1. THIS DETAIL APPLIES TO ALL SLABS ON GRADE WITH A THICKNESS OF 6" OR LARGER.

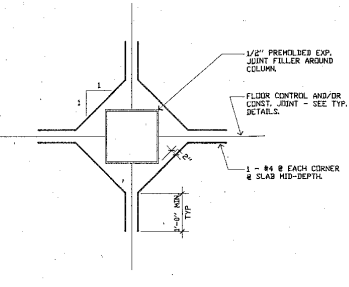


DETAIL 8
NO SCALE TYP. CONSTRUCTION JOINTS IN SLAB ON GRADE AT CONC. COLUMNS (S02)

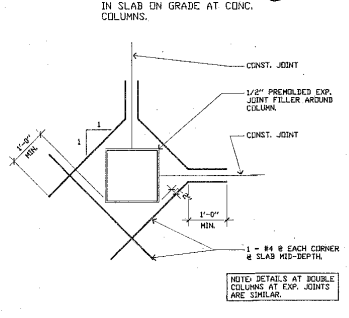


DETAIL 9
NO SCALE TYP. CONSTRUCTION JOINTS IN SLAB ON GRADE AT CONC. COLUMNS (S02)

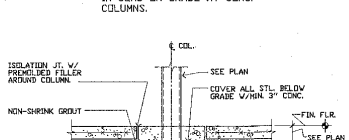


DETAIL 10
NO SCALE TYP. CONSTRUCTION JOINTS IN SLAB ON GRADE AT CONC. COLUMNS (S02)

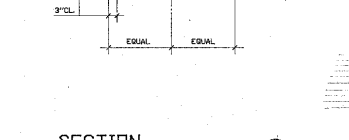


SECTION 10
NO SCALE TYP. SPREAD FTG. W/O PIER (S02)

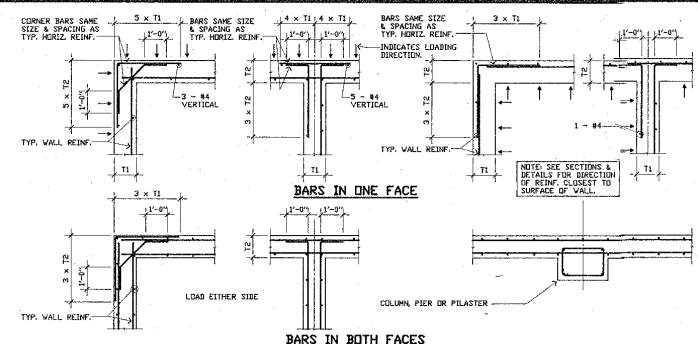


DETAIL 11
NO SCALE STL. ARRANGEMENT AT WALL CORNERS AND INTERSECTIONS (S02)

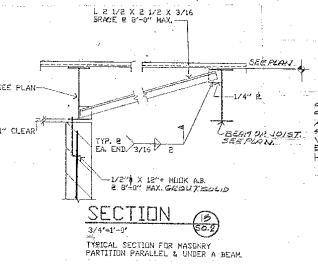


SECTION 12
TYPICAL SECTION FOR MASONRY PARTITION PARALLEL & UNDER A BEAM (S02)

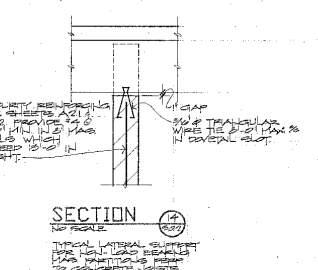


SECTION 13
TYPICAL LATERAL SUPPORT FOR MASONRY PARTITIONS (S02)

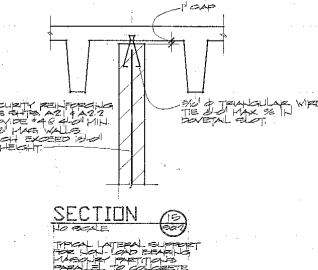


SECTION 14
TYPICAL LATERAL SUPPORT FOR MASONRY PARTITIONS (S02)

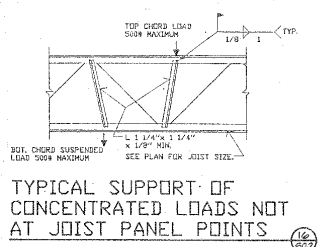


SECTION 15
TYPICAL SUPPORT OF CONCENTRATED LOADS NOT AT JOIST PANEL POINTS (S02)

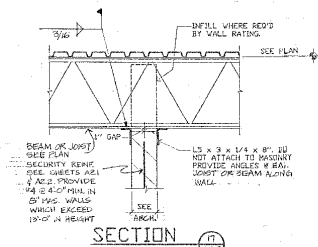


SECTION 16
TYPICAL LATERAL SUPPORT FOR MASONRY PARTITIONS (S02)

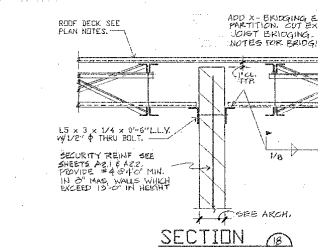


SECTION 17
TYPICAL LATERAL SUPPORT FOR MASONRY PARTITIONS (S02)

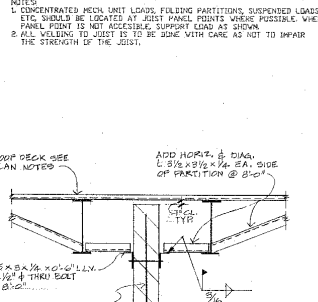

SECTION 18
TYPICAL LATERAL SUPPORT FOR MASONRY PARTITIONS (S02)

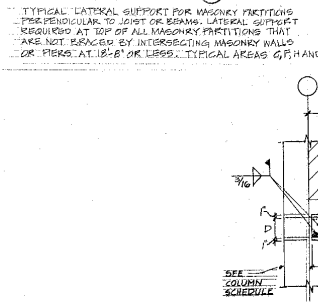


SECTION 19
TYPICAL LATERAL SUPPORT FOR MASONRY PARTITIONS (S02)

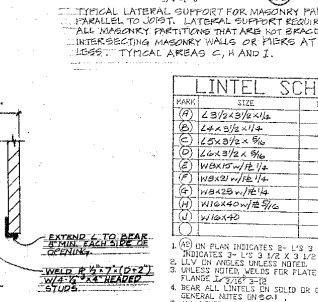

SECTION 20
TYPICAL LATERAL SUPPORT FOR MASONRY PARTITIONS (S02)

MARK	SIZE	QTY	REMARKS
(A)	2" x 4" x 1/2"		
(B)	2" x 4" x 1/2"		
(C)	2" x 4" x 1/2"		
(D)	2" x 4" x 1/2"		
(E)	2" x 4" x 1/2"		
(F)	2" x 4" x 1/2"		
(G)	2" x 4" x 1/2"		
(H)	2" x 4" x 1/2"		
(I)	2" x 4" x 1/2"		

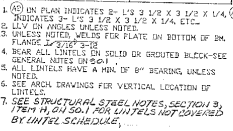

SECTION 21
TYPICAL LATERAL SUPPORT FOR MASONRY PARTITIONS (S02)

SAI SILLING ASSOCIATES, INC.
ARCHITECTS - PLANNERS
400 CARYL STREET - SUITE 200 - 202
CHARLESTON, W. VA. 25323 - (304) 546-0905

ROSSER FABRAP
ROSSER FABRAP INTERNATIONAL
ARCHITECTS, ENGINEERS, AND PLANNERS
ATLANTA, SAVANNAH, TAMPA, SAN DIEGO AND COUNTY CO. VA.

SEAL OF WEST VIRGINIA
STATE OF WEST VIRGINIA
REGISTERED PROFESSIONAL ARCHITECT

REVISIONS
RECORD DRAWING 9-5-95

MOUNT OLIVE CORRECTIONAL COMPLEX

WEST VIRGINIA REGIONAL JAIL & CORRECTIONAL FACILITY AUTHORITY

KEY PLAN
DRAWING TITLE
TYPICAL DETAILS
DATE
DECEMBER 9, 1991
DRAWING NO.
S0.2

NOTES:
FOR STRUCTURAL WORK INCLUDED IN THE SITE DEVELOPMENT PHASE II AND PARALLELS CONTACT SEE THE SPECIFICATIONS AND DRAWING NO. S1.4, SECTION 1.03.4 AND NOTES.
FOR STRUCTURAL WORK INCLUDED IN THIS CONTRACT SEE THE SPECIFICATIONS AND DRAWING NO. S1.4, SECTION 1.03.4 AND NOTES.