


SAI SILLING ASSOCIATES, INC.
 ARCHITECTS · PLANNERS
 405 CAPITOL STREET · SUITE 300 · BOX 887
 CHARLESTON, W. V. 25323 · (304) 346-0385


This drawing and all parts of it are the property of SILLING ASSOCIATES, INC. (SAI). Prices are to be returned to SAI upon completion of use for which they were issued. Reproduction of this drawing without the written consent of SAI is not permitted.

ROSSER FABRAP

Rosser Fabrap International
 Architects, engineers, and planners
 Atlanta, Savannah, Tampa, San Bernardino County
 524 West Peachtree Street, N.W.
 Atlanta, Georgia 30308 0680
 (404) 876-3800

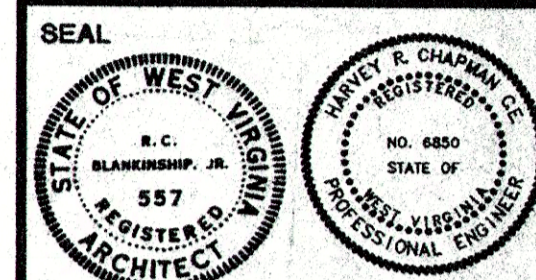


REVISIONS
 1. 7/15/96 - REPLACED CHLORINE CONTACT TANK WITH UV DISINFECTION CHANNEL
 2. 6/26/97 - RECORD DRAWING

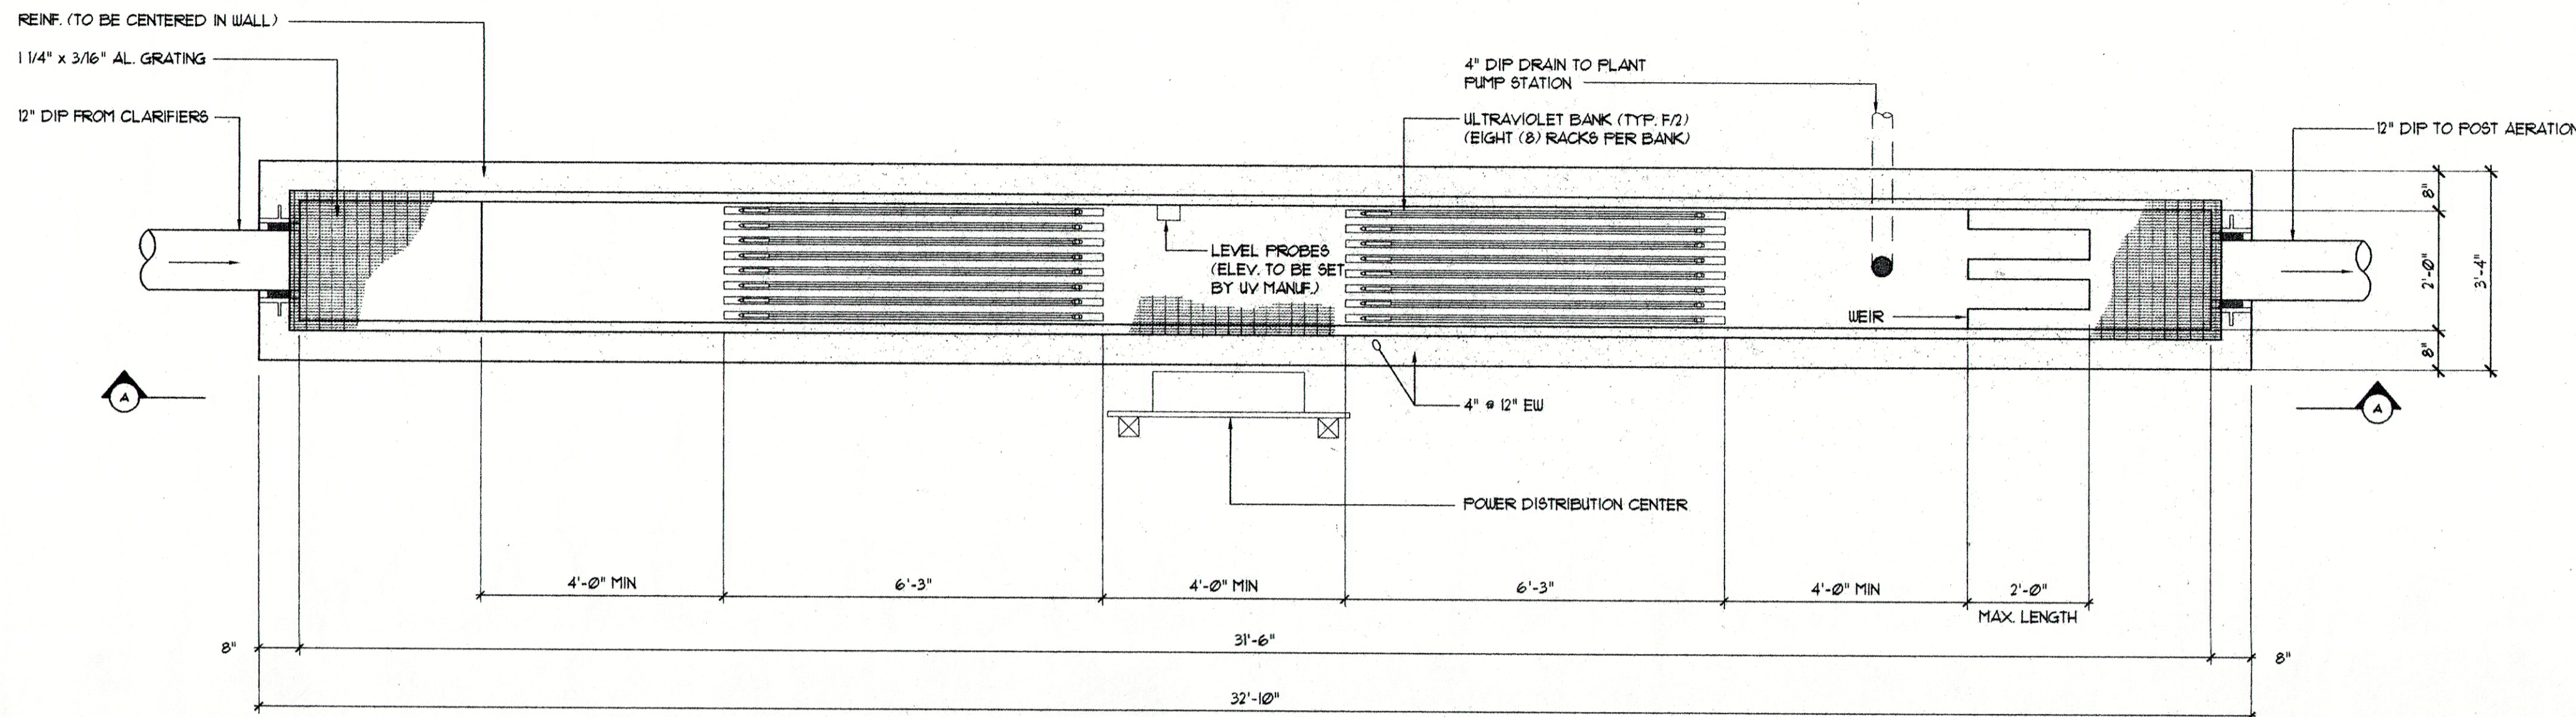


ULTRAVIOLET DISINFECTION SYSTEM PLAN
 SCALE: 1/2" = 1'-0"

NOTES:
 1. THE CHANNEL FLOOR MUST BE KEPT WITHIN A TOLERANCE OF 1/4"
 2. DIMENSION OF CHANNEL WIDTH MUST BE KEPT WITHIN A TOLERANCE OF 1/4"

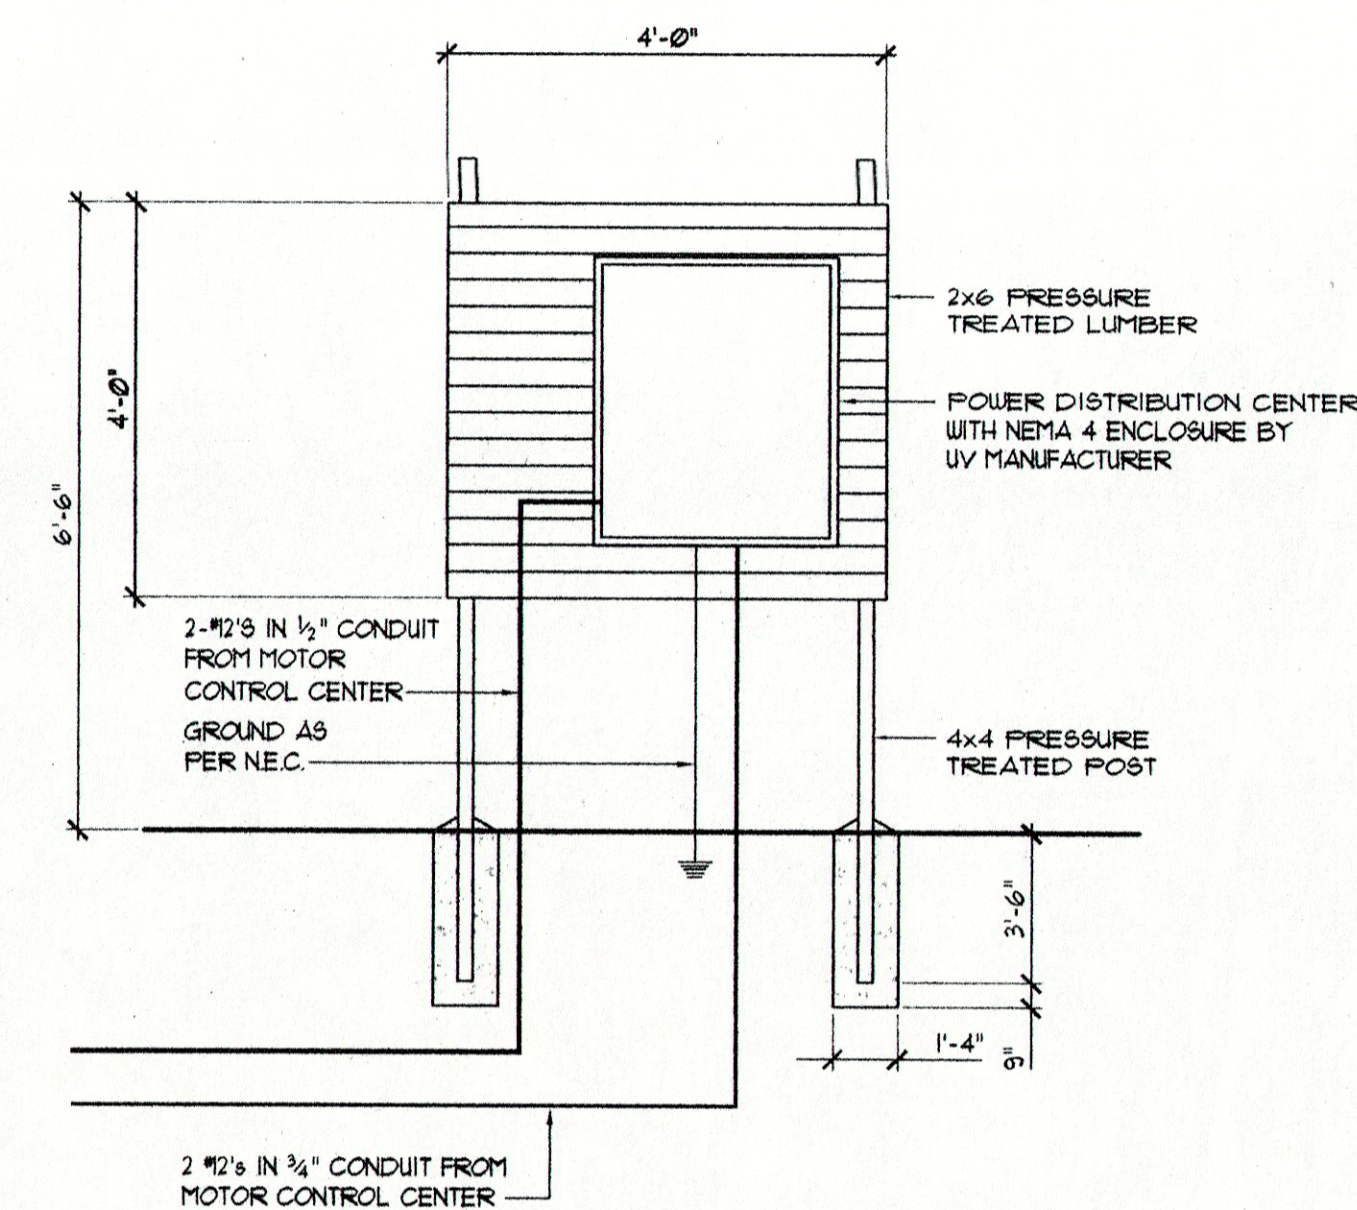

POWER DISTRIBUTION CONTROL SCHEMATIC
 SCALE: NONE

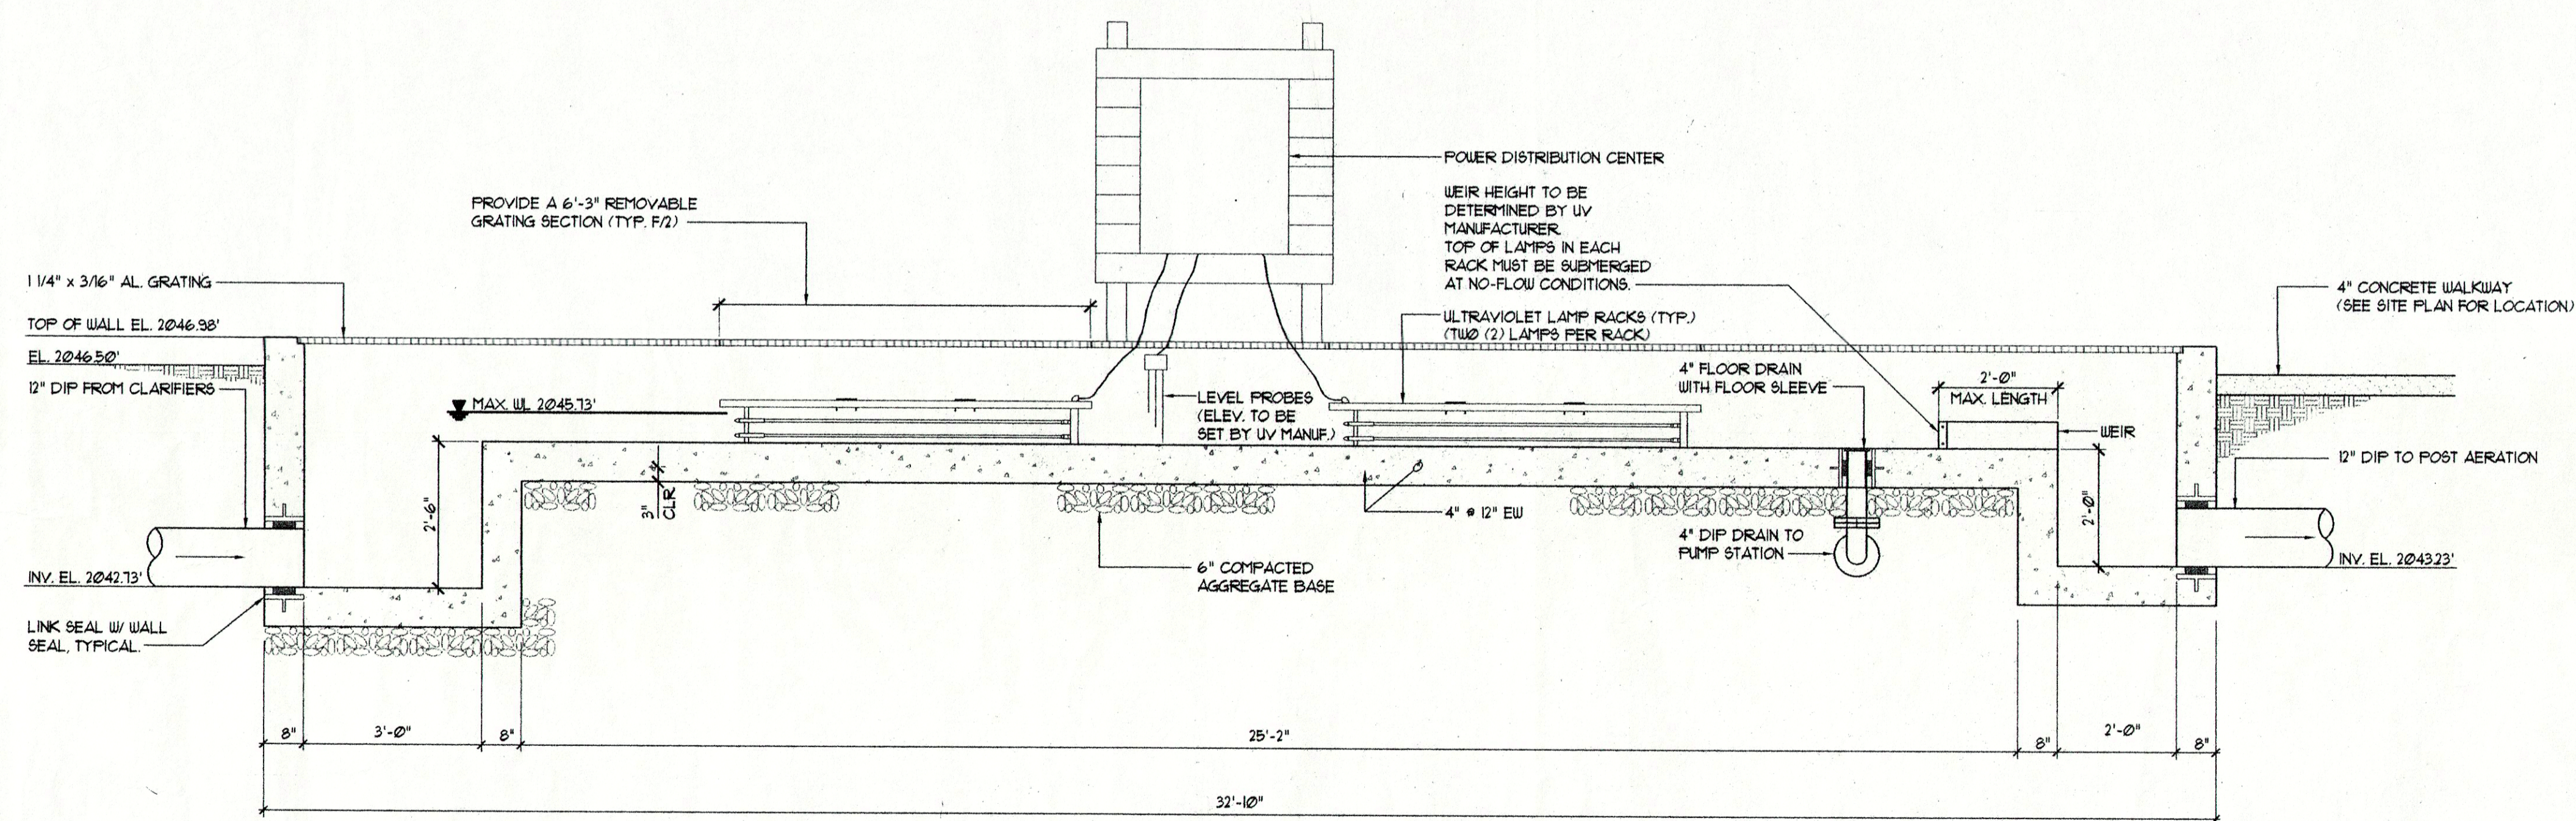

ULTRAVIOLET DISINFECTION SYSTEM SECTION
 SCALE: 1/2" = 1'-0"

WASTEWATER TREATMENT PLANT IMPROVEMENTS
HUTTONSVILLE CORRECTIONAL CENTER
 WEST VIRGINIA REGIONAL JAIL & CORRECTIONAL FACILITY AUTHORITY

KEY PLAN

DRAWING TITLE

ULTRAVIOLET DISINFECTION SYSTEM PLAN, SECTION, DETAIL

DATE 24 JULY 1995

DRAWING NO.

13