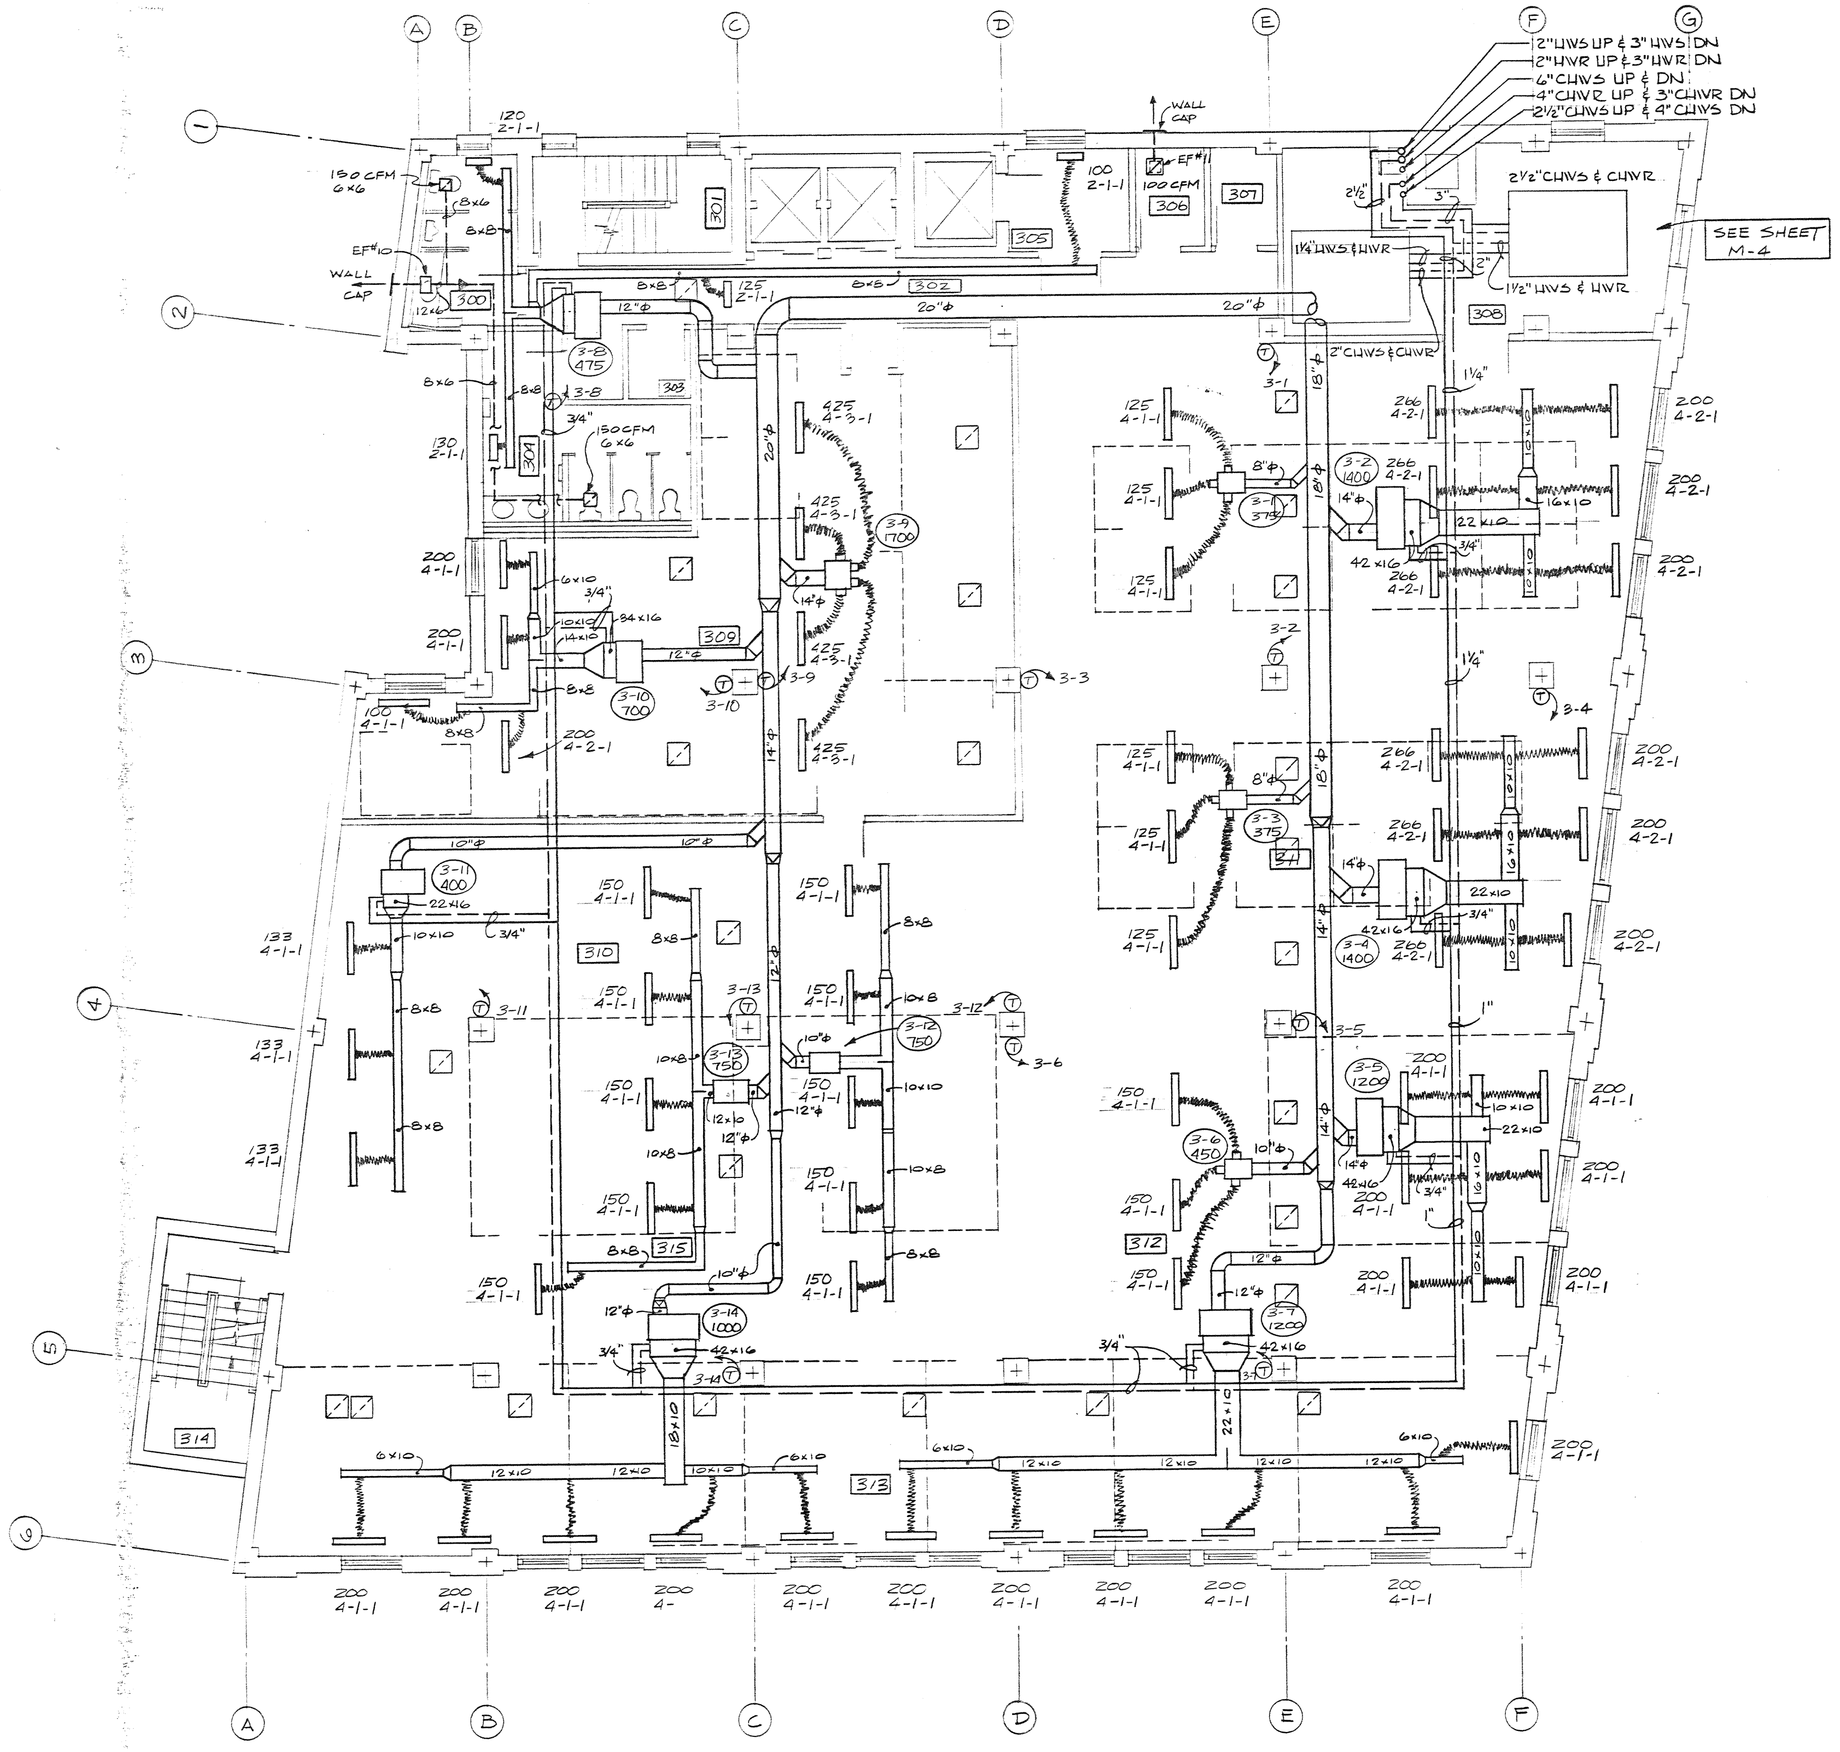

THIRD FLOOR PLAN

SCALE: 1/8"=1'-0"

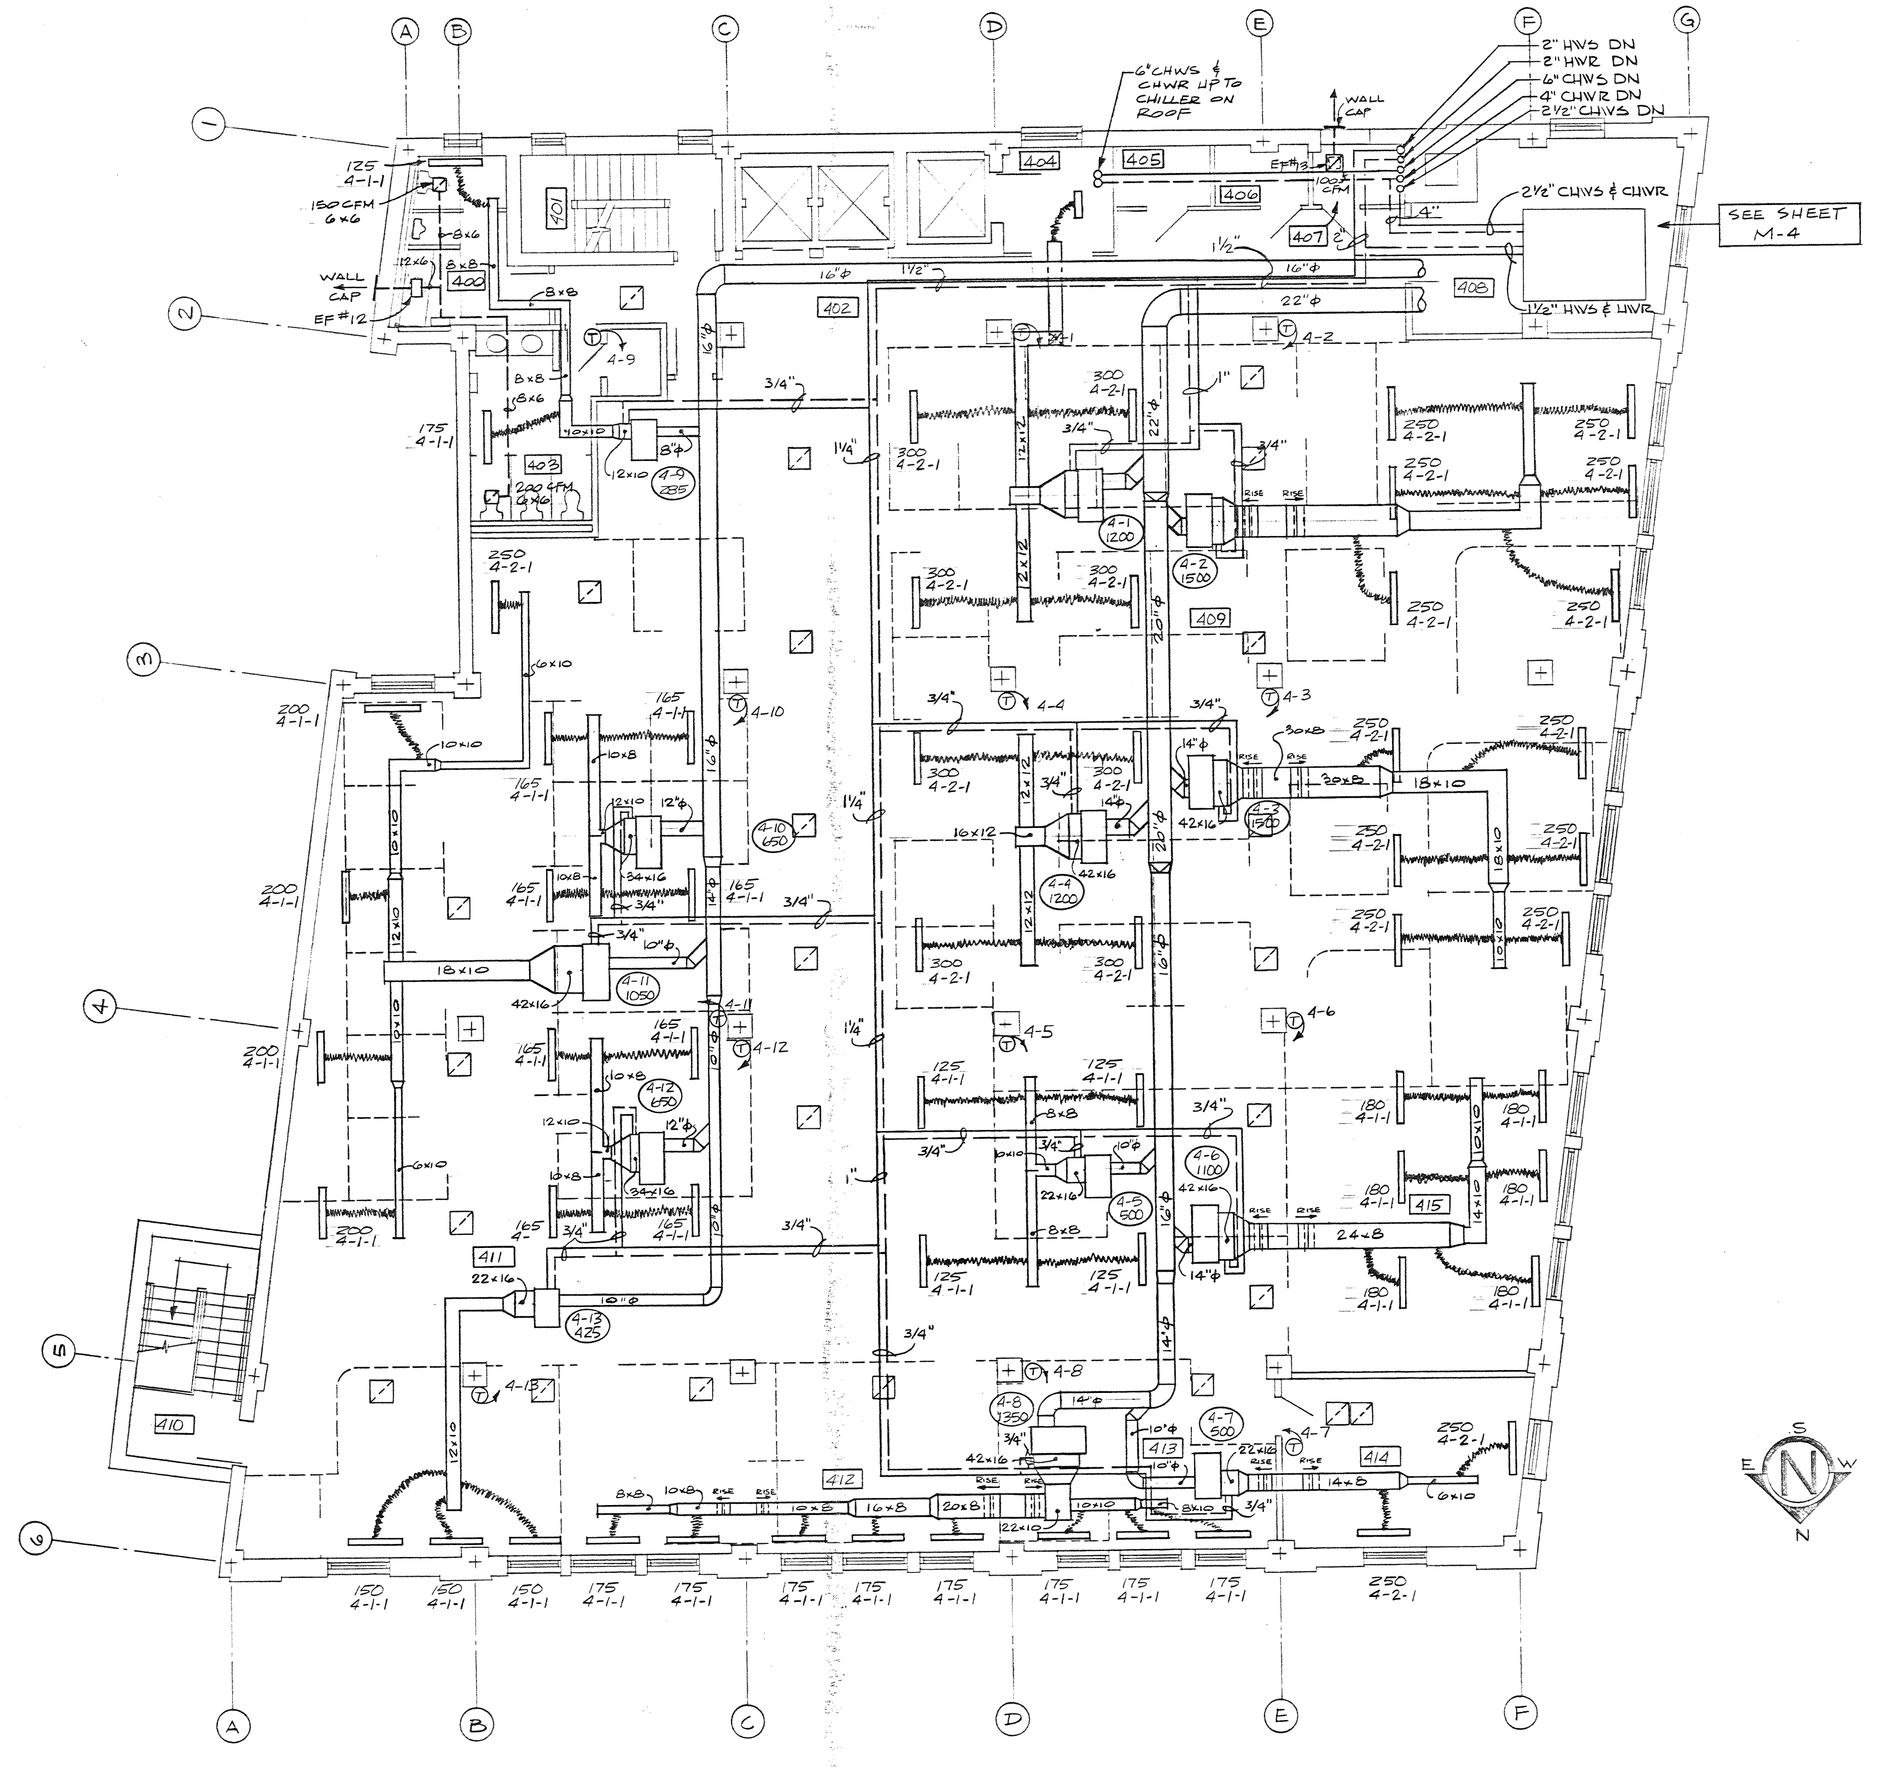

FOURTH FLOOR PLAN

SCALE: 1/8"=1'-0"

CHANGED PER AS-BUILT CONDITIONS APRIL 26, 1988

THIRD & FOURTH FLOOR PLAN - H.V.A.C.

REMODELING the FORMER COYLE - RICHARDSON BUILDING
Lee & Dickinson St. Charleston, WV.

WEST VIRGINIA STATE BUILDING COMMISSION, BUILDING #2
(West Virginia State Tax Department, Revenue Operations Center)

IRVING BOWMAN & ASSOCIATES
Architects and Engineers
107 Hale St. Box 1827, Charleston, WV, 25327

HOBLITZELL, DALEY & McINTYRE
Consulting Architects
107 Hale St., Charleston, WV, 25301

J. COOK ENGINEERING
Consulting Engineers
405 Capitol St. Box 1342, Charleston, WV, 25325

PAUL C. COOK, M.E. REGISTERED No. 4843 STATE OF West Virginia PROFESSIONAL ENGINEER

Scale: 1/8" = 1'-0"

Date: APRIL, 1987

Drawing No: M-3