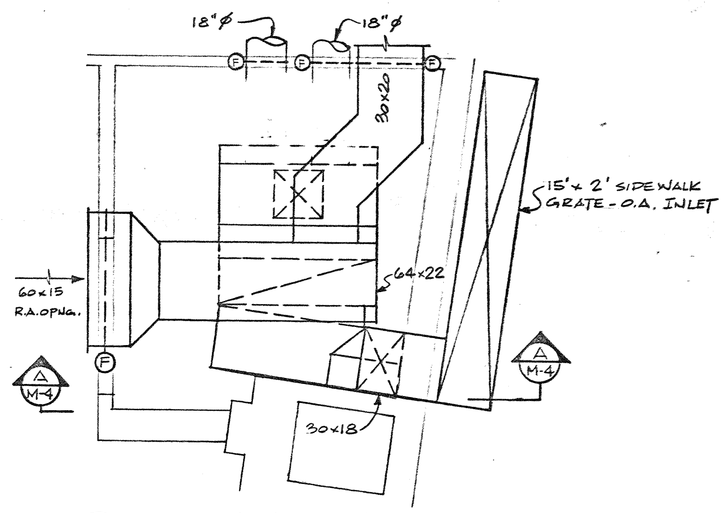

BSMT. MECH. RM.

SCALE: 1/8" = 1'-0"

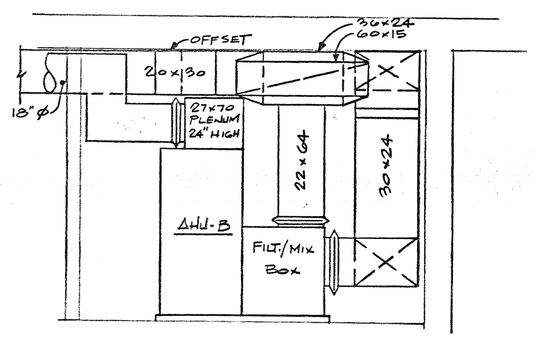

SECTION "A - A"

SCALE: 1/8" = 1'-0"

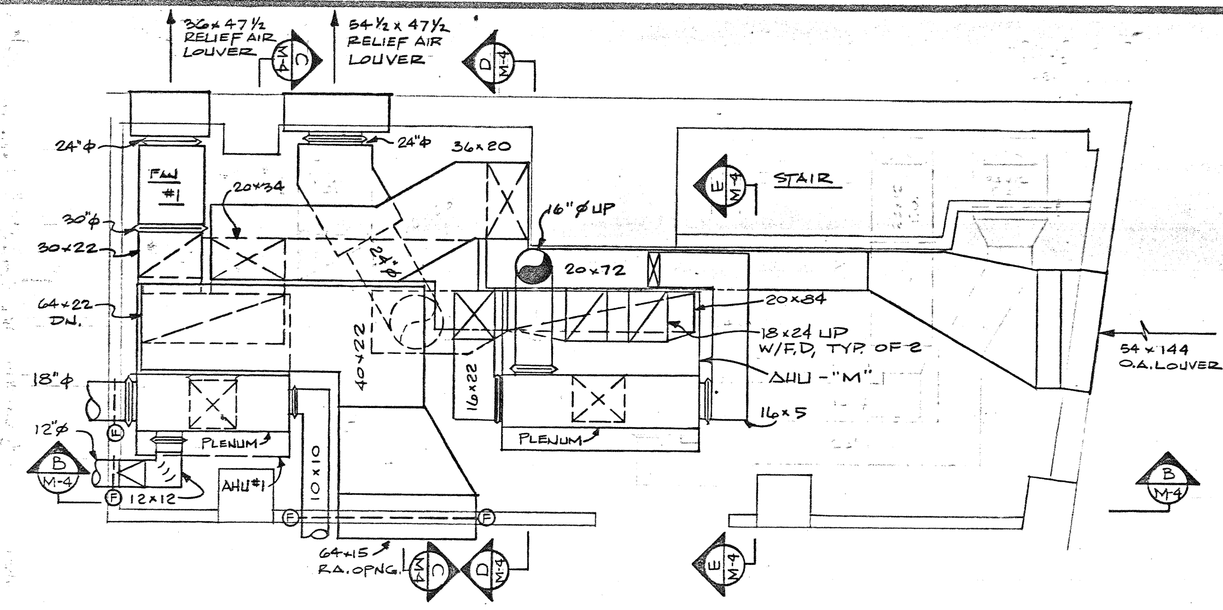

FIRST FLOOR MECH. RM.

SCALE: 1/4" = 1'-0"

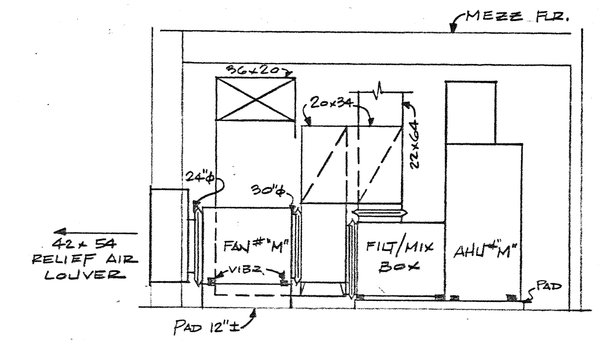

SECTION "C - C"

SCALE: 1/4" = 1'-0"

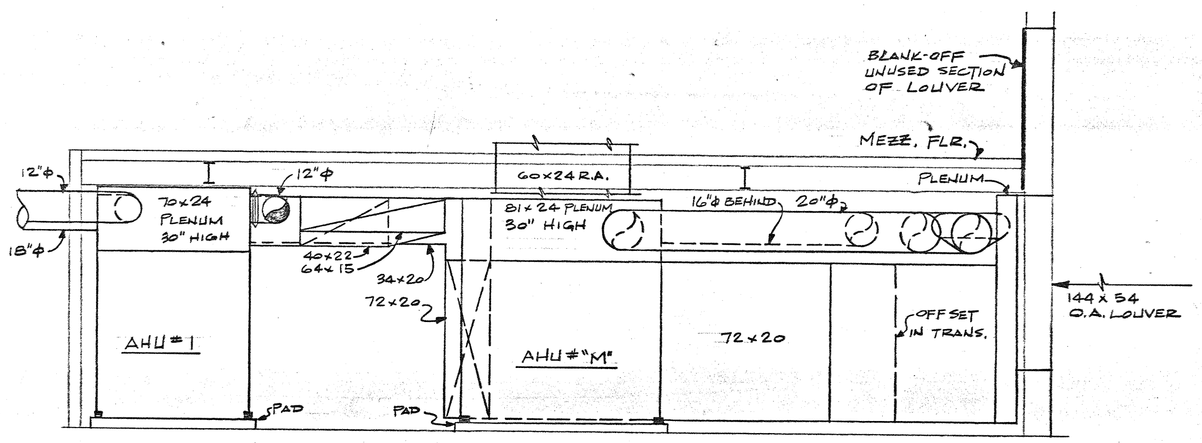

SECTION "B - B"

SCALE: 1/8" = 1'-0"

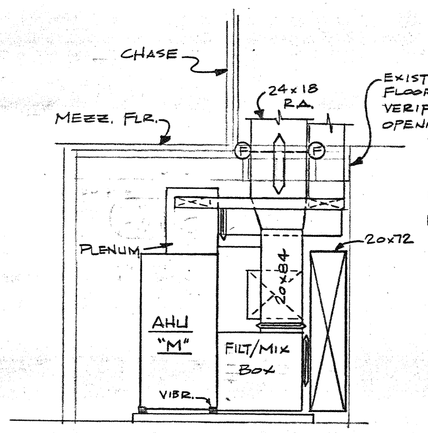

SECTION 'E - E

SCALE: 1/4" = 1'-0"

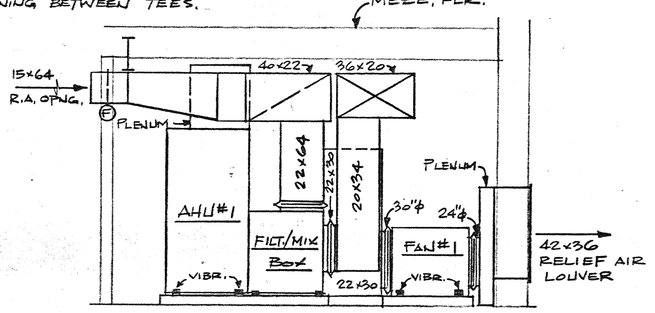

SECTION "D-D"

SCALE: 1/4" = 1'-0"

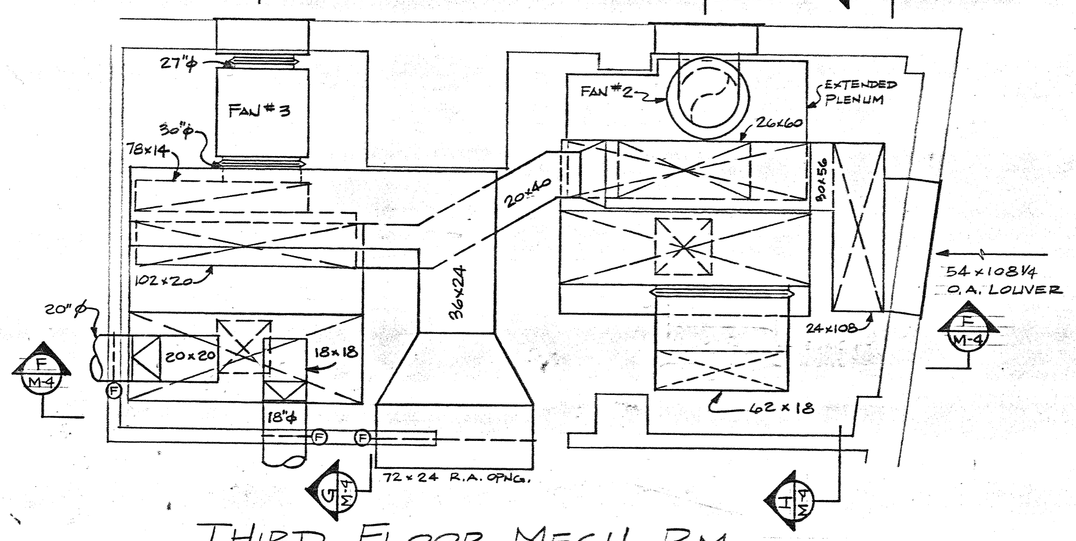

THIRD FLOOR MECH. RM.

SCALE: 1/8" = 1'-0"

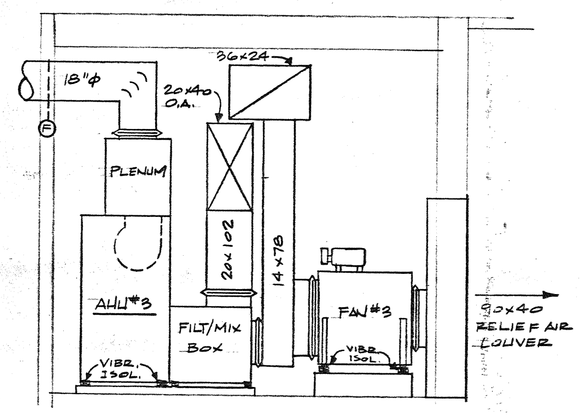

SECTION "G - G"

SCALE: 1/4" = 1'-0"

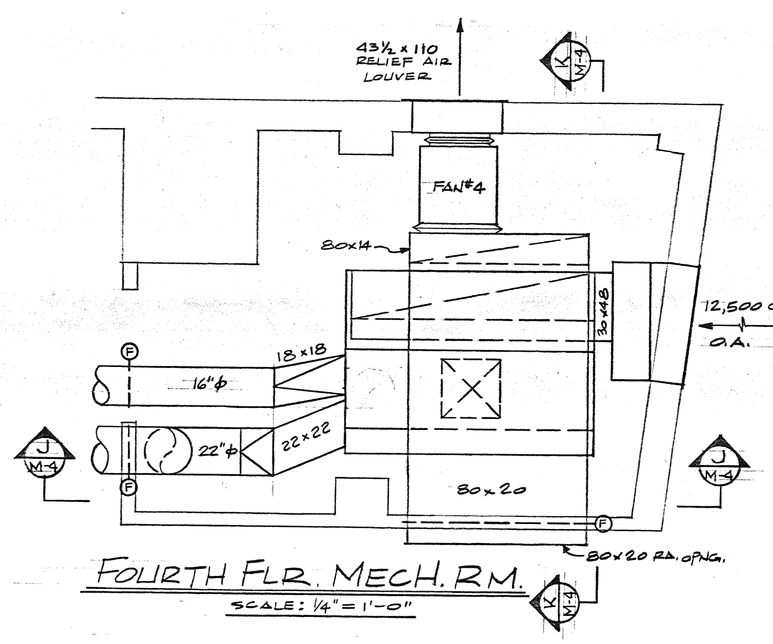

FOURTH FLR. MECH. RM.

SCALE: 1/4" = 1'-0"

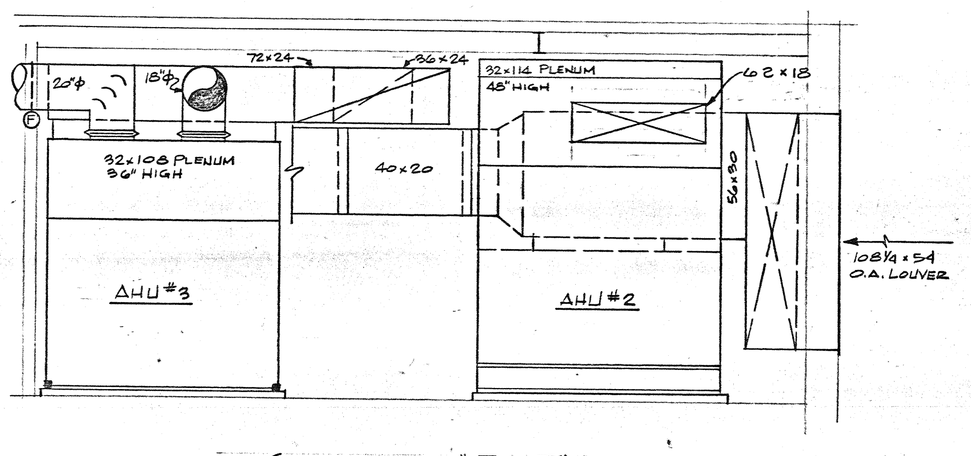

SECTION "F - F"

SCALE: 1/4" = 1'-0"

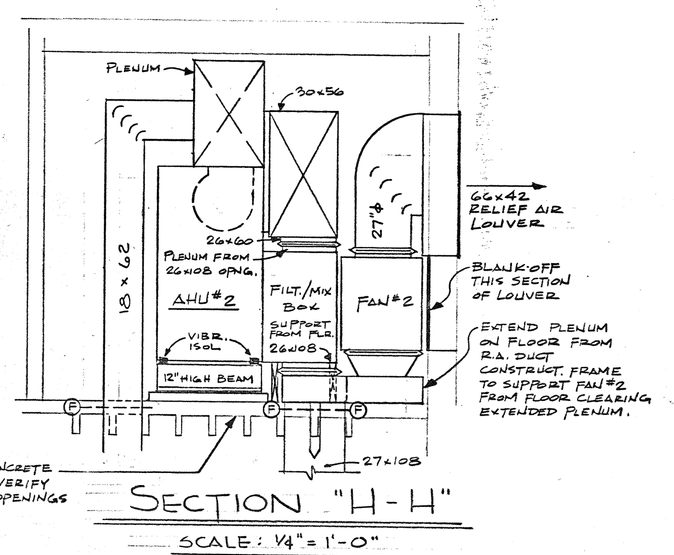

EXISTING "COFFERED" CONCRETE FLOOR CONSTRUCTION - VERIFY LOCATION & CLEAR OPENINGS BETWEEN TEE'S.

SECTION "H - H"

SCALE: 1/4" = 1'-0"

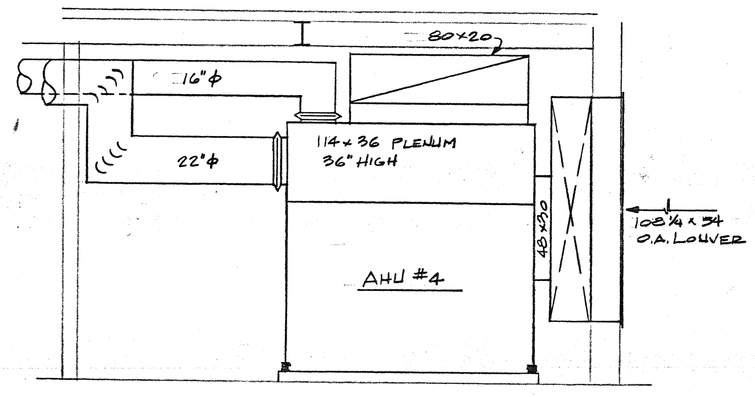

SECTION "J - J"

SCALE: 1/4" = 1'-0"

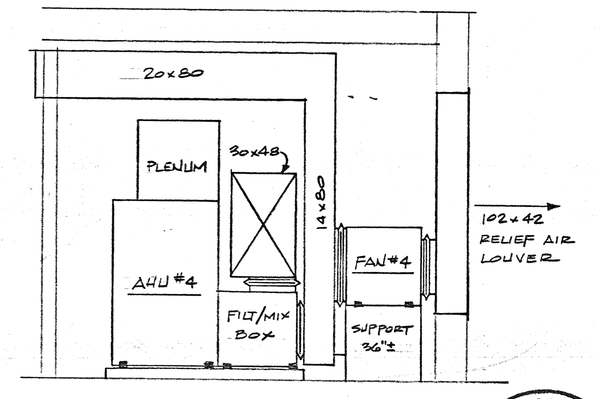

SECTION "K - K"

SCALE: 1/4" = 1'-0"

CHANGED PER AS-BUILT CONDITIONS APRIL 26, 1988

H.V.A.C. DETAILS

REMODELING the FORMER COYLE - RICHARDSON BUILDING
Lee & Dickinson St. Charleston, WV.

WEST VIRGINIA STATE BUILDING COMMISSION, BUILDING #22
(West Virginia State Tax Department, Revenue Operations Center)

M-4

IRVING BOWMAN & ASSOCIATES
Architects and Engineers
107 Hale St. Box 1827, Charleston, WV, 25327

HOBLITZELL, DALEY & McINTYRE
Consulting Architects
107 Hale St. Charleston, WV. 25301

COOK ENGINEERING
Consulting Engineers
405 Capitol St. Box 1342, Charleston, WV, 25325

PAUL C. COOK No. 4843 REGISTERED STATE OF WEST VIRGINIA PROFESSIONAL ENGINEER

Scale: SHOWN
Date: APRIL, 198
Drawing: M-4