NOTE: ALL COPINGS CHANGED TO ALUMINUM FROM PRECAST CONCRETE BY SUPPLEMENTARY INSTRUCTIONS. SEE TYPICAL DETAIL 2/A3.22.

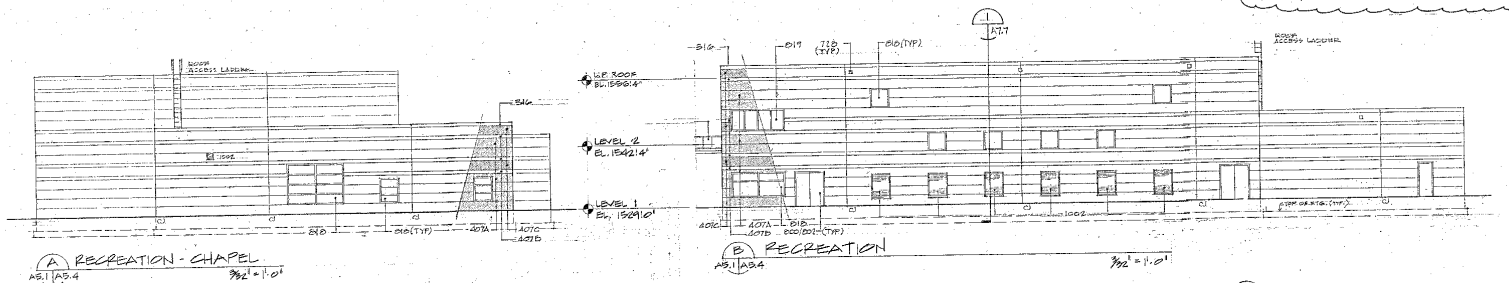

A RECREATION - CHAPEL
A5.1 | A5.4
3/32" = 1'-0"

B RECREATION
A5.1 | A5.4
3/32" = 1'-0"

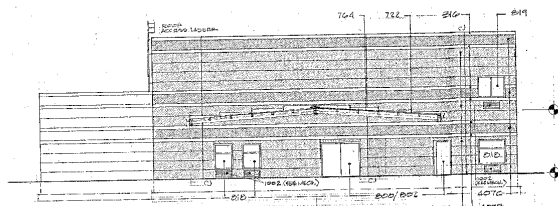

C RECREATION
A5.1 | A5.4
3/32" = 1'-0"

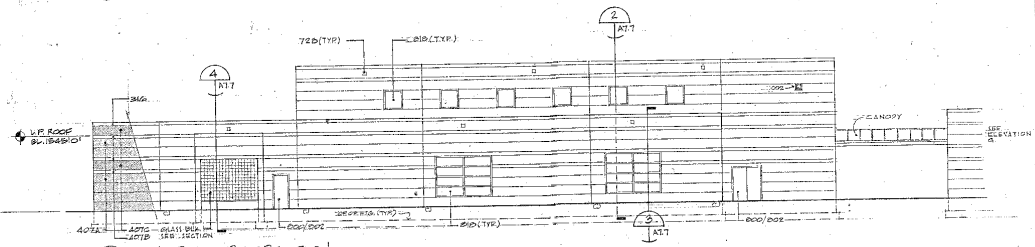

D CHAPEL - RECREATION
A5.1 | A5.4
3/32" = 1'-0"

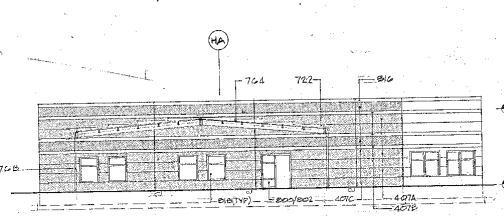

E FACILITY ADMIN. - ACADEMIC EDUC. - LIBRARY
A5.1 | A5.4
3/32" = 1'-0"

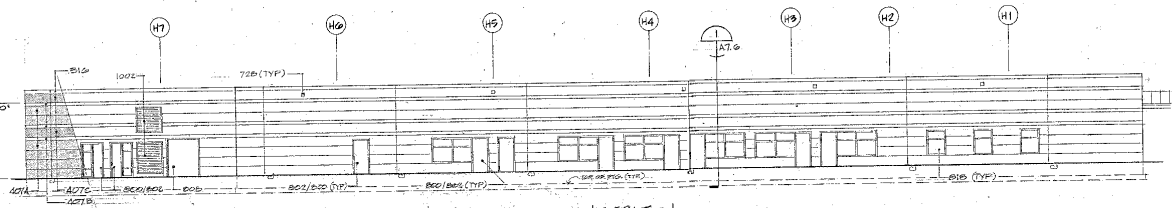

F COMMISSARY - LAUNDRY - ACADEMIC EDUCATION - FACILITY ADMINISTRATION
A5.1 | A5.4
3/32" = 1'-0"

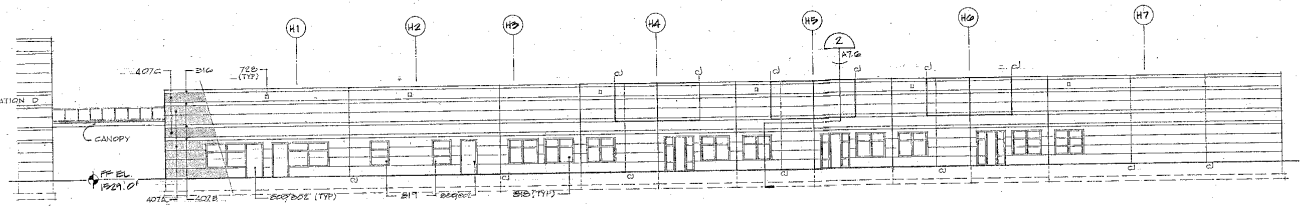

G ACADEMIC EDUCATION - LIBRARY - LAUNDRY - COMMISSARY
A5.1 | A5.4
3/32" = 1'-0"

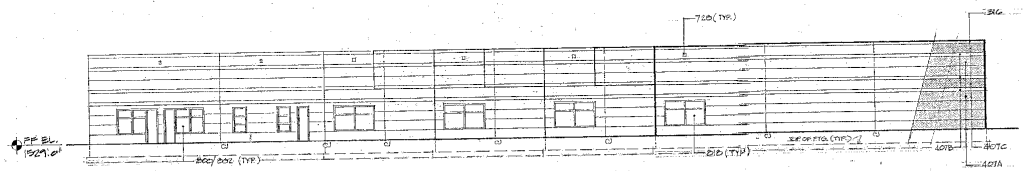

H ACADEMIC EDUCATION - LIBRARY - LAUNDRY - COMMISSARY
A5.1 | A5.4
3/32" = 1'-0"

KEY NOTES

300	WELDED WIRE FABRIC - SEE STRUCTURAL
302	DOWEL - SEE STRUCTURAL
303	THICKENED SLAB - SEE STRUCTURAL
306	CONCRETE SLAB ON GRADE
315	VAPOR BARRIER
316	CONCRETE
317	TOP TILT JOINT BOND BREAKER
318	1/2" PREMOLDED JOINT FILLER
319	CRITICAL DRAINAGE COURSE (6" THICK MINIMUM)
310	CONCRETE SLAB
311	CONCRETE SIDEWALK
312	CONCRETE PAD
313	PRECAST CONCRETE STOOL
314	CONCRETE GRADE BEAM - SEE STRUCTURAL
315	CONCRETE FOOTING - SEE STRUCTURAL
316	PRECAST CONCRETE COPING (WHITE) W/2 #4 REINFORCED BARS
317	PRECAST CONCRETE SILL
318	CONCRETE CELL UNIT
319	CONCRETE BEAM - SEE STRUCTURAL
320	CONCRETE COLUMN - SEE STRUCTURAL
321	PRECAST CONCRETE SPLASH BLOCK - 36" X 12" MINIMUM
324	CONCRETE BEAM - SEE STRUCTURAL
400	MASONRY ANCHORS
402	HORIZONTAL MASONRY REINFORCING @ 16" C/C VERTICAL
403	DOVE TAIL SLOTS W/MASONRY ANCHORS @ 24" C/C HORIZONTAL
404	THRU WALL FLASHING
406	WEEPS @ 24" C/C
407	CONCRETE MASONRY UNITS (CMU) SPLIT FACE OR SMOOTH FACE (4" NOM)
407A	CONCRETE MASONRY UNITS (CMU) SPLIT FACE (4" NOM) NATURAL
407B	CONCRETE MASONRY UNITS (CMU) SMOOTH (4" NOM) WHITE
407C	CONCRETE MASONRY UNITS (CMU) SPLIT FACE (4" NOM) COLORED
408	CONCRETE MASONRY UNITS (8" NOM)
409	CONCRETE MASONRY UNITS (12" NOM)
412	GROUT
414	GROUT SOLID ALL CELLS VERTICAL REINFORCING - SPACING AS INDICATED OR STRUCTURAL OR DEFLECTED CEILING PLANS
500	STEEL BEAM - SEE STRUCTURAL
502	STEEL COLUMN - SEE STRUCTURAL
504	STEEL FRAMING - SEE STRUCTURAL
505	STEEL LINTEL - SEE STRUCTURAL
506	STEEL ANGLE - SEE STRUCTURAL
507	STEEL CHANNEL - SEE STRUCTURAL
508	STEEL PLATE - SEE STRUCTURAL
509	STEEL BAR JOISTS - SEE STRUCTURAL
510	STEEL BAR JOISTS - SEE STRUCTURAL
514	METAL DECK - SEE STRUCTURAL FOR TYPE AND THICKNESS
515	METAL DECK CLOSURE
516	PREFABRICATED METAL JOIST - SEE STRUCTURAL
518	CONCRETE FILLED METAL PANEL STEEL STAIR
520	STEEL TREAD OPEN RISER STEEL STAIR
524	1.66# O.D. STEEL PIPE RAIL
525	1.9" O.D. STEEL PIPE RAIL
526	2.375" O.D. STEEL PIPE RAIL
527	TS 2-1/4" X 2-1/4" X 3/16"
528	TS 2" X 10" X 1/4"
600	PRESSURE TREATED WOOD BLOCKING
602	PLYWOOD (CDX) AND TYPE AS INDICATED)
604	PLASTIC LAMINATE
700	PROTECTION BOARD
701	DAMPPROOFING
702	MEMBRANE WATERPROOFING
706	R-19 FIBERGLASS INSULATION
708	SOUND INSULATION
709	HORIZONTAL SLAB INSULATION 2" X 24"
710	RIGID INSULATION 2" THICK
712	ROOF INSULATION - 2 LAYERS
714	TAPERED INSULATION
716	EPDM ROOF - FULLY ADHERED
717	BASE FLASHING
722	METAL FLASHING
724	METAL COUNTER FLASHING
728	EPDM FLASHING
730	GAIN LEADER 6" X 5" U.N.O.
728	METAL SCUPPER
732	ROOF LEADER HEAD
734	METAL CAP
736	PRE-FAB ROOF CURB
737	SEALANT
738	HIGH STRENGTH PICK-RESISTANT SEALANT
739	FIRE RESISTANT SEALANT
740	SEALANT AND BACKER ROD
742	CAULKING
744	EXPANSION JOINT
746	EXPANSION JOINT COVER
748	COMPRESSIBLE FILLER
750	STUCCO SYSTEM 3-1/2" THICK U.N.O. COLOR AS SELECTED
754	STUCCO SYSTEM CONTROL JOINT
756	STUCCO SYSTEM 3/4" V-GROOVE U.N.O.
760	METAL SOFFIT - CONCEALED SEAM
762	METAL SOFFIT - STANDING SEAM
764	METAL CLOSURE
760	METAL GUTTER
800	HOLLOW METAL DOOR FRAME - SEE SPECS AND DETAILS
802	HOLLOW METAL DOOR - SEE SPECS AND DETAILS
804	WOOD DOOR
806	ACCESS DOOR
808	OVERHEAD COILING DOOR
815	METAL FINISHWORK
819	HOLLOW METAL FRAME - SEE SPECS AND DETAILS
819	SECURITY MEDIUM METAL MEMBRAN - SEE SPECS AND DETAILS
820	GLAZING - SEE SPECS AND DETAILS
900	METAL LATH AND PLASTER
902	5/8" GYPSUM BOARD
903	J-MOLD
904	3-1/8" METAL STUDS @ 16" C/C (U.N.O.
905	METAL STUDS @ 16" C/C (SIZE AS NOTED U.N.O.
910	SUSPENDED GYPSUM BOARD CEILING
912	SUSPENDED GRID PLASTER CEILING
913	SUSPENDED SECURITY PLASTER CEILING
916	CERAMIC TILE
917	QUARRY TILE
920	SUSPENDED ACOUSTIC TILE CEILING
924	CARPET
926	RESILIENT BASE
928	VINYL COMPOSITION TILE
929	TOPICK SET GROUT BED
1002	METAL COVERS
1013	CHAIN LINK FENCING
1100	DOCK BUMPER
1301	PRE-ENGINEERED BLDG SIDING PANEL
1302	PRE-ENGINEERED BLDG ROOFING PANEL
1303	PRE-ENGINEERED BLDG TRIM
1304	PRE-ENGINEERED BLDG R-30 INSULATION
1305	PRE-ENGINEERED BLDG FIBERGLASS BLANKET INSULATION
1306	PRE-ENGINEERED BLDG CLOSURE STRIP
1307	PRE-ENGINEERED BLDG BASE ANGLE
1308	PRE-ENGINEERED BLDG LINER PANEL
1309	PRE-ENGINEERED BLDG RIDGE COVER
1310	PRE-ENGINEERED BLDG ROOF CLOSURE, GUTTER AND DOWNSPOUT

SAI SILLING ASSOCIATES, INC.
ARCHITECTS · PLANNERS
405 CAPITOL STREET · SUITE 300 · BOX 987
CHARLESTON, W.V. 25323 · (304) 346-0685

This drawing and all prints of it are the property of Silling Associates, Inc. (SAI). Prints are to be returned on 2nd week completion of use for which they were issued. Reproduction of this drawing without the written consent of SAI is not permitted.

ROSSER FABRAP

Rosser Fabrap International
Architects, engineers, and planners
Atlanta, Savannah, Tampa, San Bernardino County
534 West Peachtree Street, N.W.
Atlanta, Georgia 30308-0680
(404) 876-5800

SEAL

STATE OF WEST VIRGINIA — H.G. JOHE — 380 — REGISTERED ARCHITECT

REVISIONS

RECORD DRAWING 9-5-95

MOUNT OLIVE CORRECTIONAL COMPLEX

WEST VIRGINIA REGIONAL JAIL & CORRECTIONAL FACILITY AUTHORITY

KEY PLAN

DRAWING TITLE
EXTERIOR ELEVATIONS

SCALE: 3/32"=1'-0"

DATE
12/9/91

DRAWING NO.
A5.4