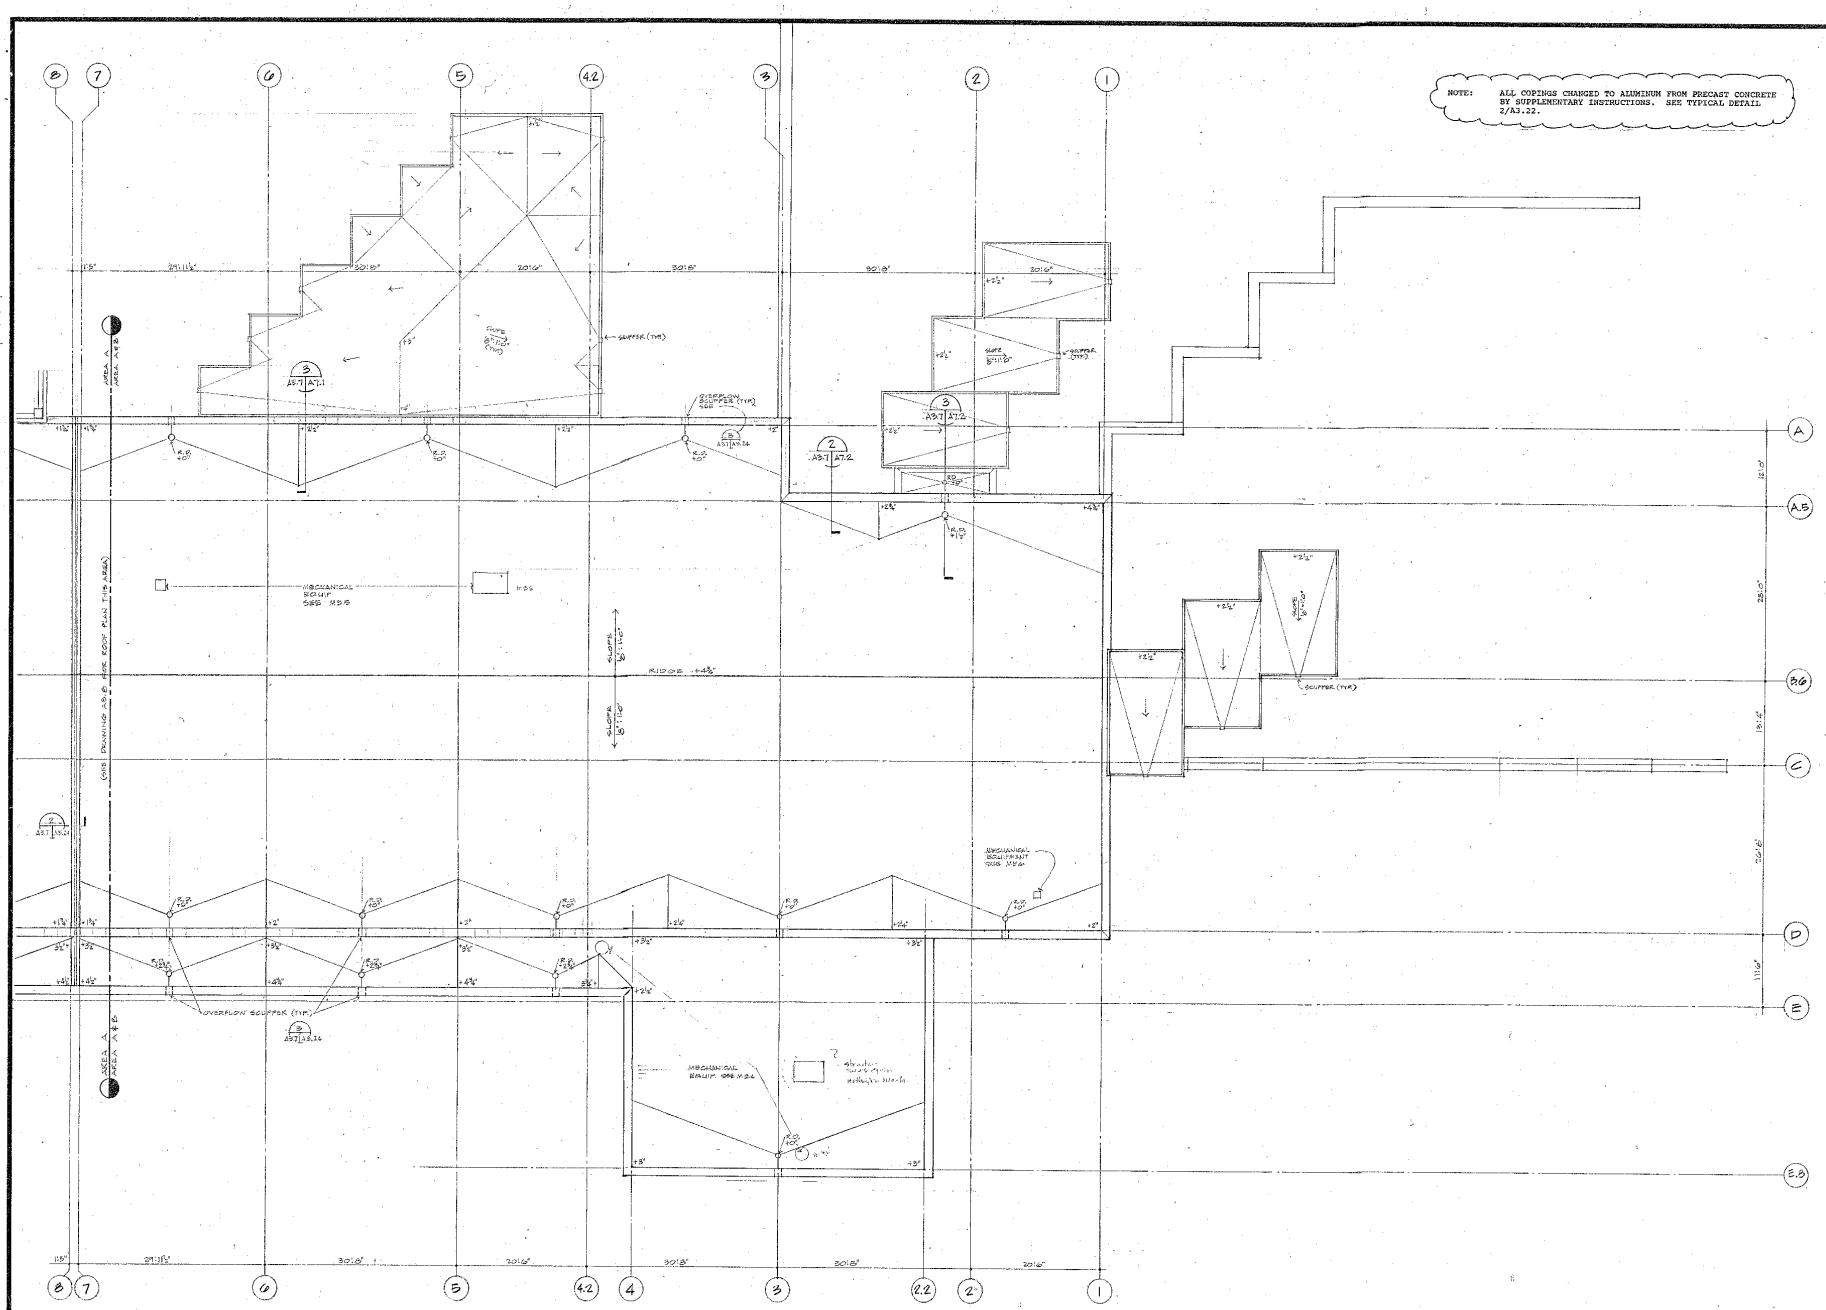

ROOF PLAN, COMPLEX ADMIN.
A3.1 | A3.7
1/8" = 1'-0"

SAI SILLING ASSOCIATES, INC.
ARCHITECTS - PLANNERS
405 CAPITOL STREET - SUITE 300 - BOX 667
CHARLESTON, W. V. 25323 - (304) 346-0565

This drawing and all prints of it are the property of SILLING ASSOCIATES, INC. 1982. Prints are to be returned to SAI upon completion of use for which they were loaned. Reproduction of this drawing without the written consent of SAI is not permitted.

ROSSER FABRAP

Rosser Fabrap International
Architects, engineers, and planners:
Atlanta, Savannah, Tampa, San Bernardino County
534 West Peachtree Street, N.W.
Atlanta, Georgia 30308-0680
(404) 876-3800

SEAL
STATE OF WEST VIRGINIA
H.G. JOHE
380
REGISTERED ARCHITECT

REVISIONS

RECORD DRAWING 9-5-95

MOUNT OLIVE CORRECTIONAL COMPLEX

WEST VIRGINIA REGIONAL JAIL & CORRECTIONAL FACILITY AUTHORITY

KEY PLAN

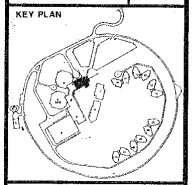

DRAWING TITLE
ROOF PLAN, COMPLEX ADMINISTRATION
AREA A & B

DATE
12/9/91

DRAWING NO.
A3.7